IREDELL COUNTY HEALTH DEPARTMENT

STATESVILLE 704-878-5305 MOORESVILLE 704-664-5281

IMPROVEMENT PERMIT / AUTHORIZATION TO CONSTRUCT / OPERATION PERMIT / EXISTING SYSTEM INSPECTION

PERMIT # 158304 PIN # 3796523236 DATE 9-29-09

OWNER or APPLICANT Brenda Steeles (Freedom Homes) PHONE: Business Home: 704-746-4778

OWNER or APPLICANT ADDRESS 126 Greenmont Point Drive Stoney Point 28678

LOCATION / DIRECTIONS I40 W → Old Mtn Road FR → TR Lindsey Farm RD → Green Point Drive - Culdesac

SUBDIVISION West Iredell Acres BLOCK / SECTION 3 LOT # 32 LOT AREA 1.173 DESIGN FLOW 480 L.T.A.R. .125

Septic Tank 1000 Gallons: STB 750 Date 4-7-9

Pump Tank Gallons: P T Date

Pump Make Model Serial #

Nitrification Field No Fields No Lines 4 Linear Feet 480

Trench Width 36" Max. Trench Bottom Depth 36" Gravel Depth NA ☑ GRAVITY ☐ PRESSURE

☑ New System ☐ Repair ☐ Expansion System Type I (II) IV V VI

System Description: 25% Low Pres

Repair System Description: 25% Pumps

Maintenance Agreement Required ☐ YES ☑ NO

☑ Residence No. Bedrooms 4 ☐ Business No. Persons ☐ Other No. Employees ☐ Slab ☑ Crawl Space ☐ Basement w/plumbing ☐ Basement w/o plumbing


Water Supply ☐ Private ☑ Public ☐ Community

Comments / Conditions

Comments / Conditions Install on contour. Maintain all setbacks.

INITIAL SITE SKETCH

AS BUILT SKETCH

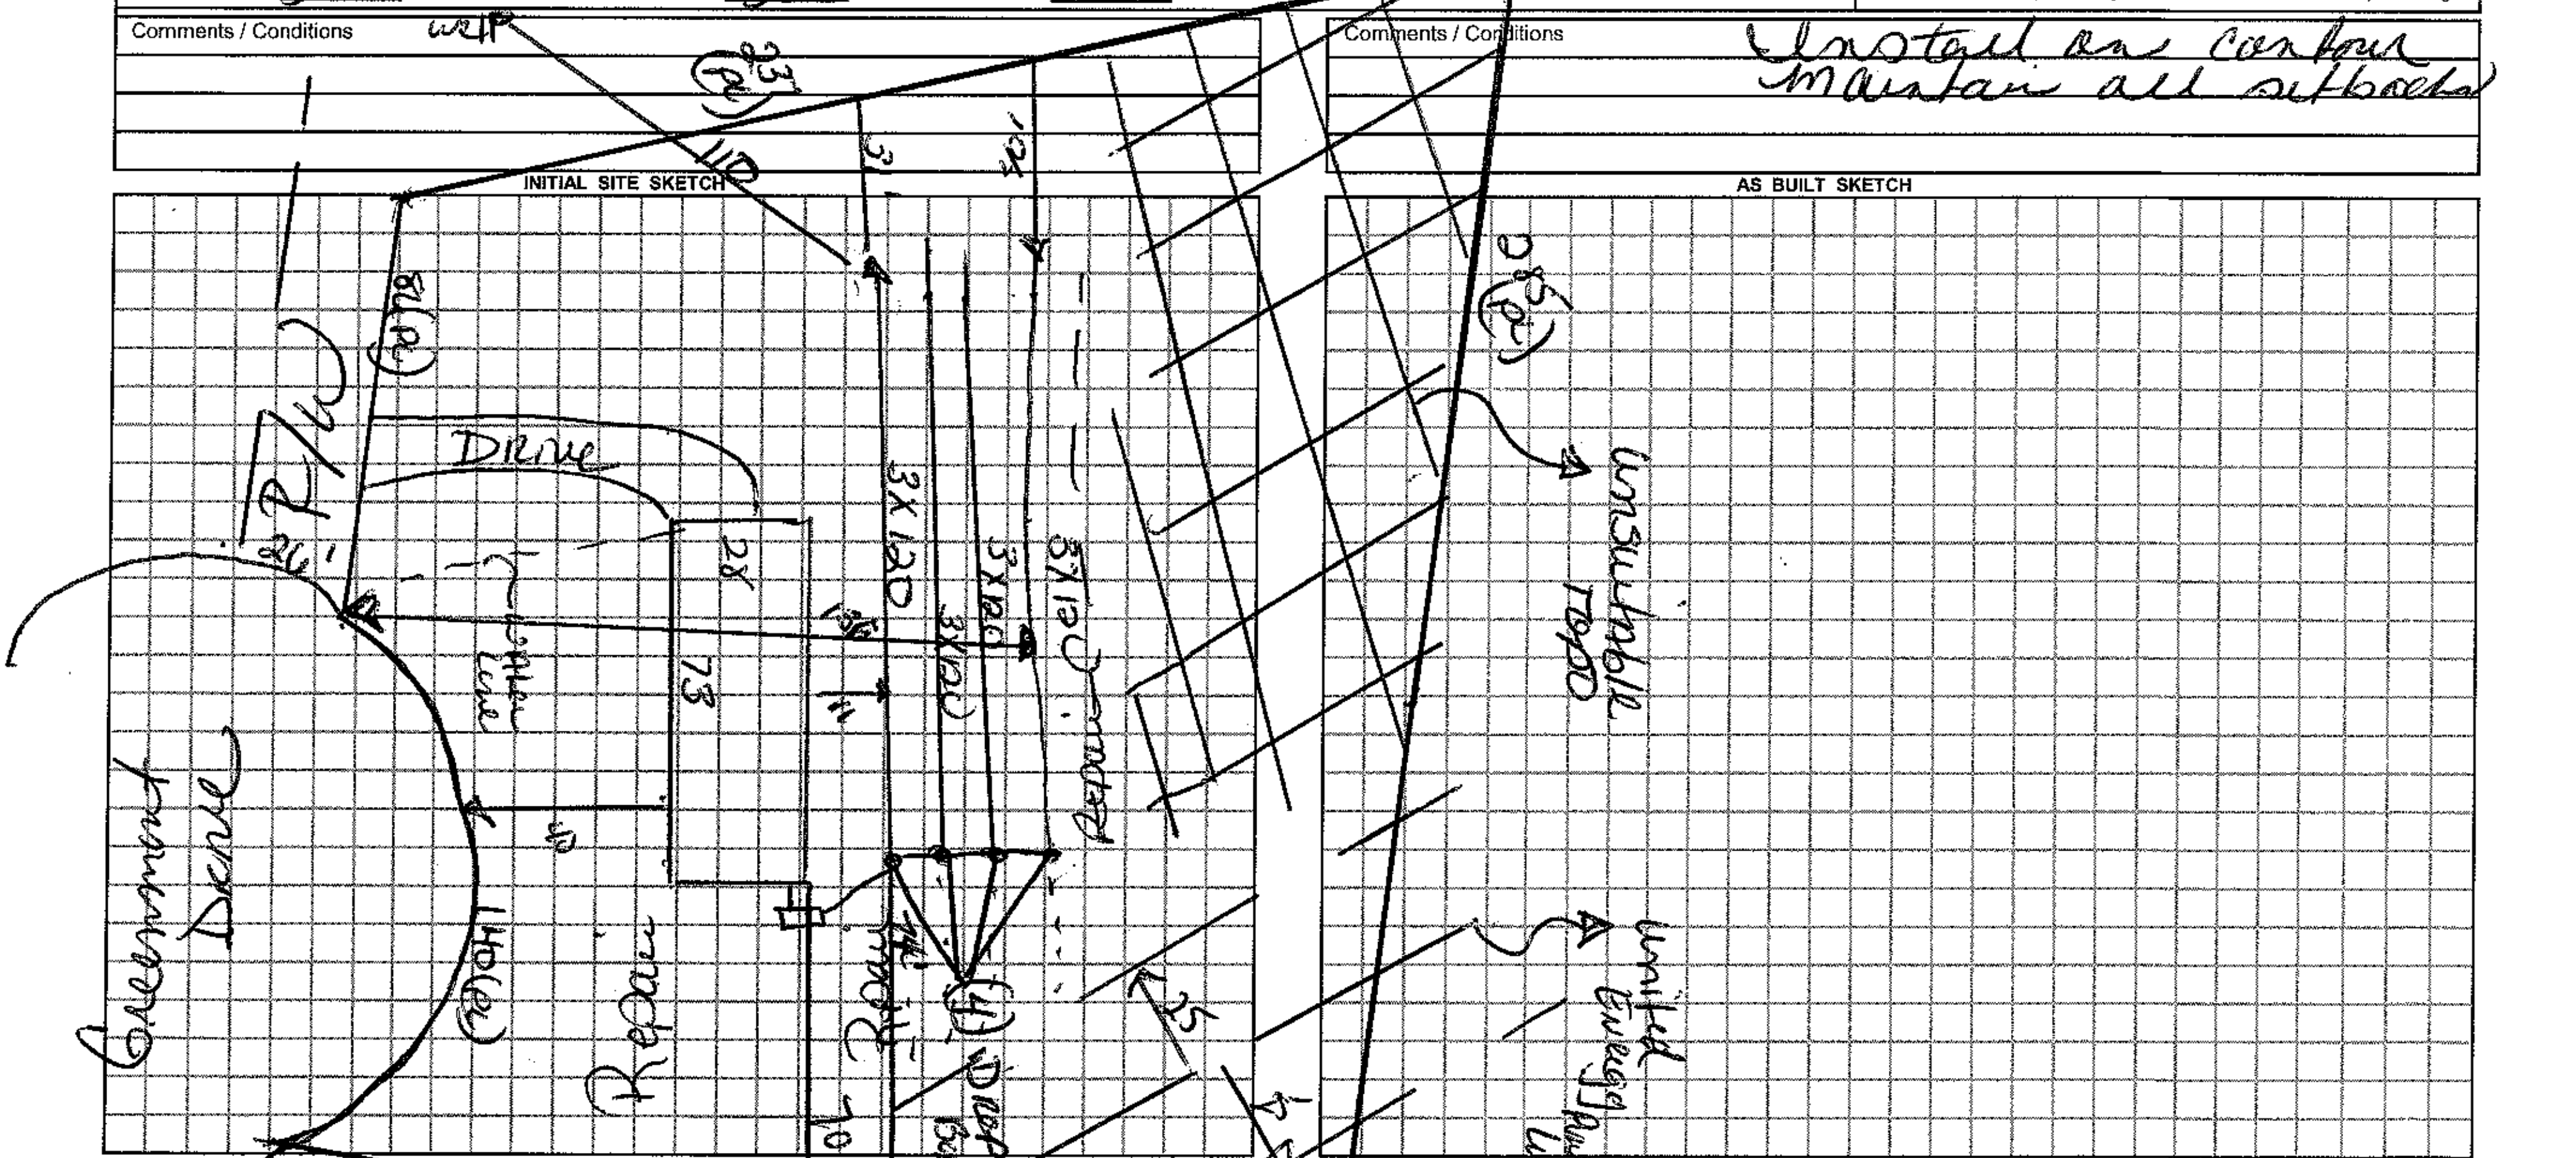

Permit can be suspended or revoked if any false information is supplied toward securing the permit / any unauthorized changes are made to the site / any unauthorized changes are made in the installation of the system.

☐ *IMPROVEMENT PERMIT w / plat valid without expiration.* ☐ *IMPROVEMENT PERMIT w / site plan valid for 60 mos.* ☑ *AUTHORIZATION TO CONSTRUCT valid for period equal to IMPROVEMENT PERMIT-not to exceed 60 mo.*

Owner / Applicant Signature: [signature] Date 9-30-09 Installed by: A-1 Backhoe

Improvement Permit by: Keith Cook Date 9-28-09 Operation Permit by: [signature] Date: 10-20-09

Authorization to Construct by: Keith Cook Date 9-28-09 Existing System Inspected by: Date:

YOU SHOULD CONTACT A LOCATOR SERVICE PRIOR TO ANY EXCAVATION.

WHITE COPY Environmental Health YELLOW COPY (Final) Owner / Applicant PINK COPY (Initial) Owner / Applicant