IREDELL COUNTY HEALTH DEPARTMENT

STATESVILLE 704-878-5305 ~~2~~ I MOORESVILLE 704-664-5281

IMPROVEMENT PERMIT / AUTHORIZATION TO CONSTRUCT / OPERATION PERMIT / EXISTING SYSTEM INSPECTION

PERMIT# 102760 PIN# 3796-53-0264 DATE 10/24/01

OWNER OR CONTRACTOR Dave Buckley PHONE: Business (704) 892-4114 Cell# Home (704) 924-4048

ADDRESS 115 King Crest Drive Mooresville, NC. 28117

LOCATION Exit 45 W, @ Oak Grove Rd, @ Lindsey Farm Rd, 1.0 mile Entrance on Left (Indian Ridge)

SUBDIVISION Lindsey Farm BLOCK / SECTION ____ LOT ____ LOT AREA +/- 40 Acres SITE CLASS 5 DESIGN FLOW 360 L.T.A.R .35

Septic Tank: 1,000 Gallons. STB 101 2 Date 3-25-02
Pump Tank: 1,000 Gallons. PT 157 Date 12-19-01
Pump Make: Goulds Model VFC 3111M Serial No E202 7312
Nitrification Field: No Fields 1 Square Feet 1029 Linear Feet 270
No Lines 3@90 Trench Width 36" Max Trench Bottom Depth 36"

[X] New System [ ] Repair System Type: I, II, III, IV, V, VI
System Description: pump 25% Reduction
Repair System Description: Pump 25% Reduction
Maintenance Agreement Required: Yes [X] No
Gravel Depth N/A


[X] House/Mod. Home No. Bedrooms 3
[ ] Mobile Home No. Bathrooms 3½
[ ] Business No. Employees ____
[ ] Other ____
[ ] Slab [ ] Crawl Space [X] Basement w/plumbing [ ] Basement wo/plumbing

Water Supply: [ ] Individual [X] Public [ ] Community

Comments/Conditions: ① Install 25% Reduction System on Contour ② Maintain proper setbacks ③ Keep System min. 50ft from Lake

Comments/Conditions: Poly Lok Sitter Installed, ST + FT marker + risers installed, lines charged okay 5/24/02 ~~-~~ Float tree + Pressure Check okay 9/4/02 - Electrical Okay

INITIAL SITE SKETCH (Not To Scale)

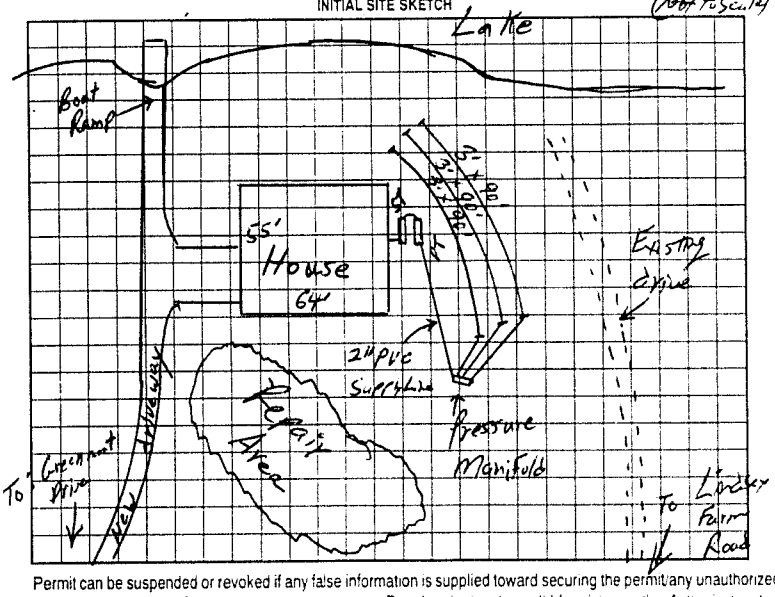

AS BUILT SKETCH

Installed as Shown per Initial Site Sketch

Permit can be suspended or revoked if any false information is supplied toward securing the permit/any unauthorized changes are made to the site any unauthorized changes are made in the installation of the system. Improvement Permit with plat valid without expiration. Improvement Permit with site plan valid for sixty months. Authorization to Construct is valid for a period equal to that of Improvement Permit – not to exceed sixty months.

Signed: DR Daly date 10/24/01 Installed by: Steve Jordan

Improvement Permit by: William C. Johnson date 10/24/01 Operation Permit by: William C. Johnson R.S. date 9/4/02

Authorization to Construct by: William C. Johnson date 10/24/01 Existing System Inspection by: ____ date ____

HEALTH DEPT COPY WHITE OWNER COPY (FINAL) YELLOW OWNER COPY (INITIAL) PINK