IREDELL COUNTY HEALTH DEPARTMENT

STATESVILLE 704-878-5305 MOORESVILLE 704-664-5281

IMPROVEMENT PERMIT / CERTIFICATE OF COMPLETION / OPERATION PERMIT / EXISTING SYSTEM INSPECTION

PROPERTY DESCRIPTION NO. 6920n DATE 9-11-97 TAX MAP NO. 3796 56 8131 Watershed: ☐ Yes ☐ No

OWNER OR CONTRACTOR Rodney ~~Goodlett~~ Caudle PHONE: Business _____ Home 704 585 6327

ADDRESS 344 West Lackey Fm Rd

LOCATION 64 West To West Lackey Fm Rd 1st House on left behind Part Dairy

SUBDIVISION _____ BLOCK / SECTION _____ LOT _____ LOT AREA 30.89 acres SITE CLASS. PS DESIGN FLOW 1250 gal L.T.A.R. .3

Septic Tank: 1000 Gallons; STB 1007 Date 6-19-97

Pump Tank: _____ Gallons; PT _____ Date _____

Pump Make: _____ Model _____ Serial No. _____

Nitrification Field: No Fields 1 Square Feet 600 Linear Feet 200

No Lines 2 Trench Width 36" Max Trench Bottom Depth 36" Gravel Depth 12"

☑ New System ☐ Repair System Type: I, II, III, IV, V, VI

System Description: Conv. Gravity

Repair System Description: " "

Maintenance Agreement Required: ☐ Yes ☑ No

☐ House/Mod. Home No. Bedrooms ____

☐ Mobile Home No. Bathrooms ____

☑ Business No. Employees 5

☐ Other 30x60 manufacturing


☑ Slab ☐ Crawl Space ☐ Basemcnt w/plumbing ☐ Basement wo/plumbing

Water Supply: ☑ Individual ☐ Community ☐ Public


Comments:

Comments:

INITIAL SITE SKETCH

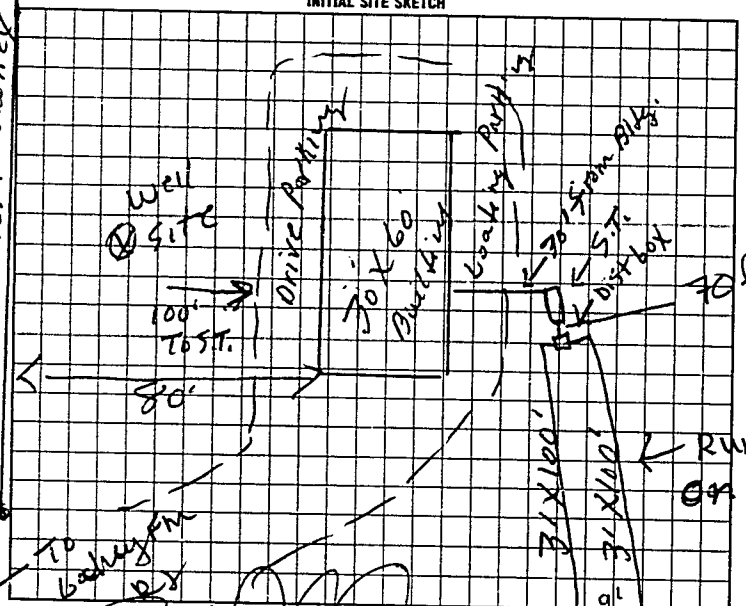

AS BUILT SKETCH

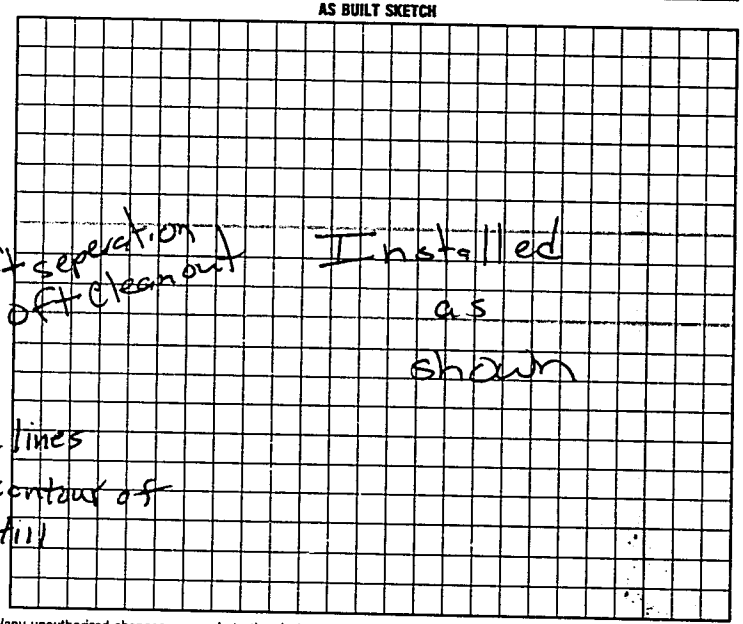

I understand that this permit can be suspended or revoked if any false information is supplied toward securing the permit/any unauthorized changes are made to the site/any unauthorized changes are made in the installation of the system. Improvement Permit is valid for 60 months from date of issuance.

Signed: X

Improvement Permit by: D.C. moore date 9-11-97

~~Existing System Inspection by~~ Authorization D.C. moore date 9-11-97

to Const.

Installed by: Wm Adam II

Certificate of Completion by: _____ date _____

Operation Permit by: Mark Cauthen date 10-8-97

Authorization to Const Expires 60 mos from issue

HEALTH DEPT. COPY: WHITE INSPECTION COPY (FINAL): GREEN OWNER COPY (FINAL): YELLOW INSPECTION COPY (INITIAL): PINK OWNER COPY (INITIAL): GOLD