IREDELL COUNTY HEALTH DEPARTMENT

Statesville Office (704) 878-5305 Mooresville Office (704) 660-3625 PERMIT # 212938

IMPROVEMENT PERMIT / AUTHORIZATION TO CONSTRUCT / OPERATION PERMIT / EXISTING SYSTEM

PIN # 3796715716 ✓

APPLICANT: Sunny Day Landscaping APPLICANT ADDRESS: 4690 Leepers St. Fran Station NC

SITE ADDRESS: 128 Lindsey Farm Rd PHONE: 704-813-4494 ALT. PHONE: N/A


SITE DIRECTIONS: Hwy 64W to L E. Lackey Farm Rd TL Miracle Farm Rd TR Lindsey Farm Rd.

SUBDIVISION: E.F. Nicholson SECTION: N/A LOT # TR 1 LOT AREA: 82.35 acres DESIGN FLOW: 360 gpd L.T.A.R.: 0.3


Septic Tank	1000	(gal)	STB	Infiltrator	Date	IM=10/6	☑ New System	☐ Repair	☐ Expansion	System Type: I II ☑III IV V VI	☑ Residence	No. Bedrooms	3	Water Supply
Pump Tank		(gal)	PT		Date		System Description:	25% Reduction			☐ Business	No. Persons	6	☐ Private
Pump Make		Model			Serial #		Repair System Description:	25% Reduction			☐ Other	No. Employees		☑ Public
# Nitrification Fields	1	# Lines	2		Linear Ft:	300	Maintenance Agreement Required:	☐ YES	☑ NO		☐ Slab	☑ Crawl Space		☐ Community
Trench Width	36"	Max. Trench Bottom Depth	36"		Gravel Depth	N/A	☐ GRAVITY	☐ PRESSURE			☐ Basement w/plumbing		☐ Basement w/o plumbing	

Comments / Conditions: Install a 25% Reduction System on contours with serial distribution. Install trench bottom @ 36" on high side. Submit floor plan prior to CA!

INITIAL SITE SKETCH

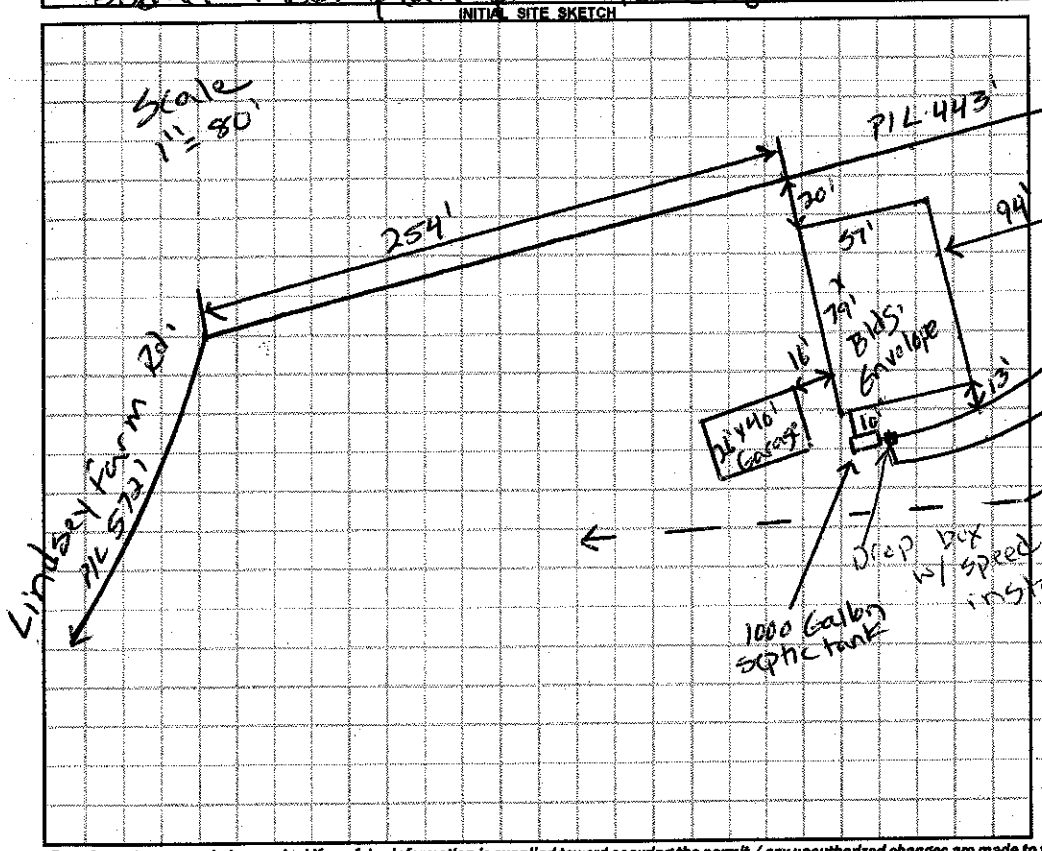

AS BUILT SKETCH

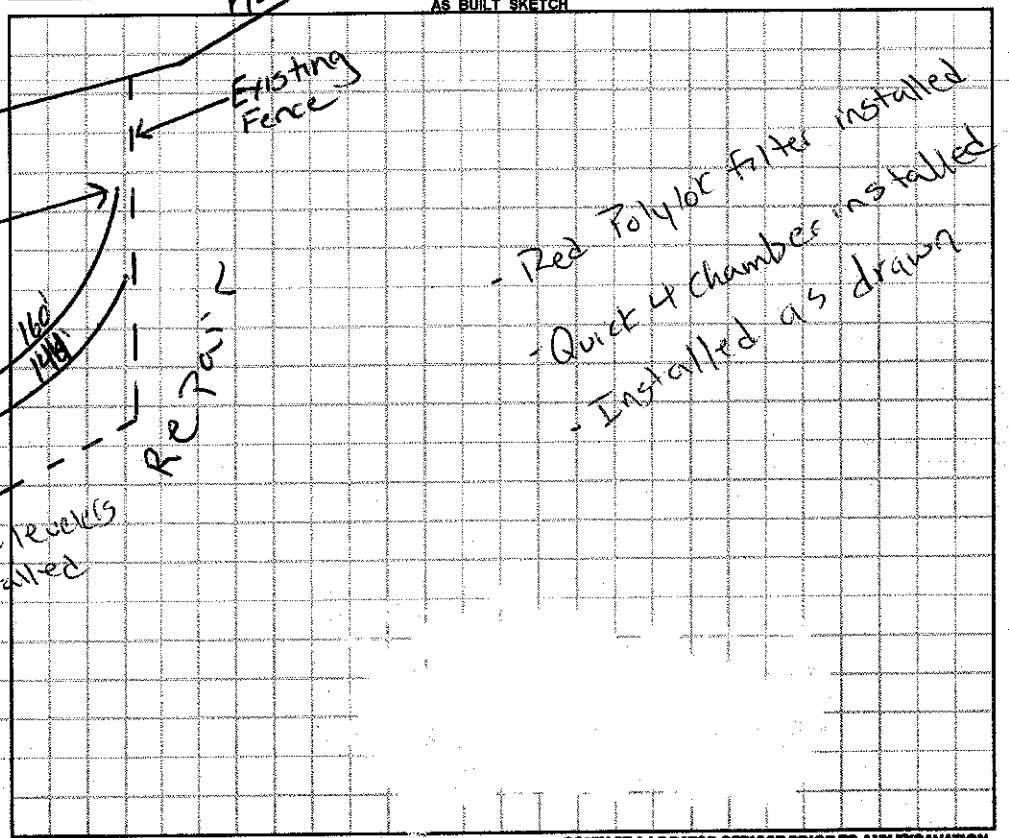

Permit can be suspended or revoked if any false information is supplied toward securing the permit / any unauthorized changes are made to the site / any unauthorized changes are made in the installation of the system. **CONTACT A LOCATOR SERVICE PRIOR TO ANY EXCAVATION**

☐ **IMPROVEMENT PERMIT** *with plat valid without expiration.* ☐ **IMPROVEMENT PERMIT** *with site plan valid for 60 mos.* ☑ **AUTHORIZATION TO CONSTRUCT** *valid for period equal to IMPROVEMENT PERMIT--not to exceed 60 mo.*

Owner / Applicant Signature: [signature] Date: Installed by: Boddi Long Grading

IMPROVEMENT PERMIT by: Justin Henderson Date: 9-25-15 OPERATION PERMIT by: Justin Henderson Date: 2-10-16

AUTHORIZATION TO CONSTRUCT by: Justin Henderson Date: 10-1-15 Existing System Inspected by: Date:

10-1-15 (AC)

Health Dept. Copy - WHITE Applicant (Final Approval) - YELLOW Applicant (Conditional Approval) - PINK