IREDELL COUNTY HEALTH DEPARTMENT

Statesville Office (704) 878-5305 Mooresville Office (704) 660-3625 PERMIT # 205206

IMPROVEMENT PERMIT / AUTHORIZATION TO CONSTRUCT / OPERATION PERMIT / EXISTING SYSTEM

PIN # 3796737445

APPLICANT: Wayne York APPLICANT ADDRESS: 194 Warren Bridge Rd Union Grove NC

SITE ADDRESS: 147 W. Lackey Farm Rd Stony Point NC PHONE: 704-929-0386 ALT. PHONE: 704-585-2269

SITE DIRECTIONS: Hwy 90 (E) to Lackey Farm Rd Approx 1½ mile house on left

SUBDIVISION: N/A SECTION: N/A LOT # N/A LOT AREA: 8.11ac DESIGN FLOW: EX L.T.A.R.: EX

Septic Tank 1000 (gal) STB 1012 Date 4-14-14
Pump Tank (gal) PT Date
Pump Make Model Serial #
Nitrification Fields 1 # Lines EX Linear Ft: EX
Trench Width EX Max. Trench Bottom Depth EX Gravel Depth EX


☐ New System ☒ Repair ☐ Expansion System Type: I/II/III IV V VI
System Description: Tank
Repair System Description:
Maintenance Agreement Required: ☐ YES ☒ NO
☑ GRAVITY ☐ PRESSURE

☒ Residence No. Bedrooms EX
☐ Business No. Persons EX
☐ Other No. Employees
☐ Slab ☒ Crawl Space
☐ Basement w/plumbing ☐ Basement w/o plumbing


Water Supply: ☒ Private ☐ Public ☐ Community

Comments / Conditions: Pump, crush, and fill existing tank. maintain maximum 6" of cover over tanks or risers

INITIAL SITE SKETCH

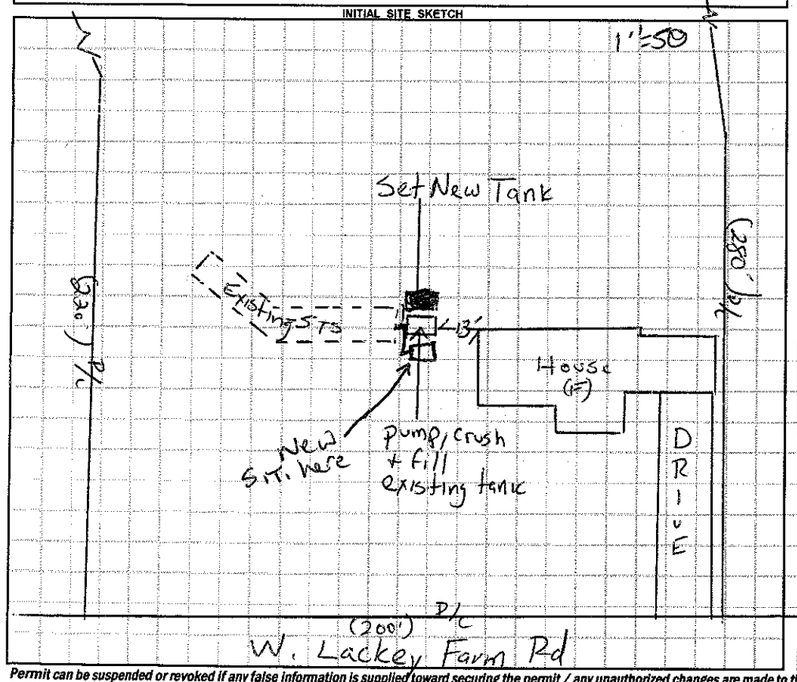

AS BUILT SKETCH

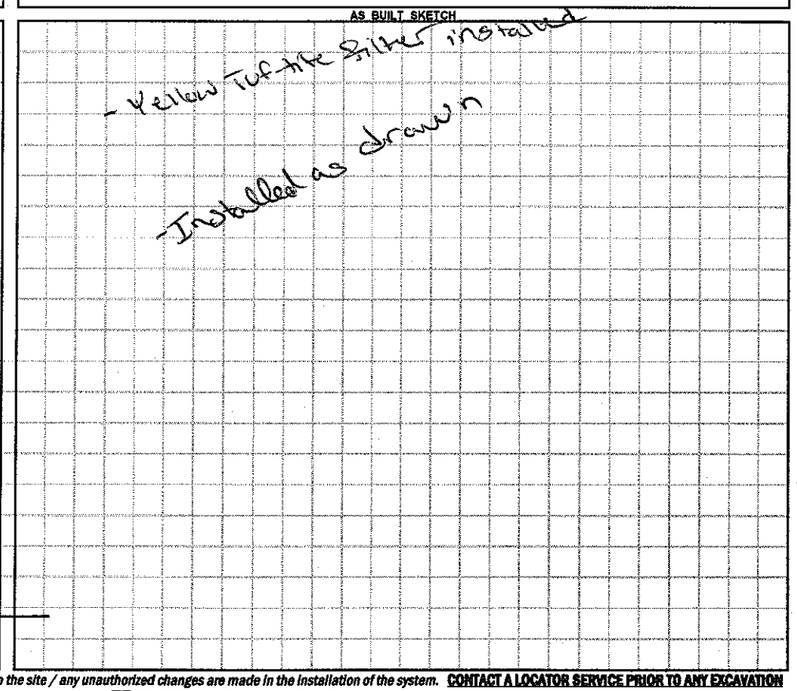

Permit can be suspended or revoked if any false information is supplied toward securing the permit / any unauthorized changes are made to the site / any unauthorized changes are made in the installation of the system. **CONTACT A LOCATOR SERVICE PRIOR TO ANY EXCAVATION**

☐ **IMPROVEMENT PERMIT** *with plat valid without expiration.* ☒ **IMPROVEMENT PERMIT** *with site plan valid for 60 mos.* ☒ **AUTHORIZATION TO CONSTRUCT** *valid for period equal to IMPROVEMENT PERMIT--not to exceed 60 mo.*

Owner / Applicant Signature: Wayne B York Date: 8/18/14 Installed by: Steve Jordan

IMPROVEMENT PERMIT by: Robert H. Lowe Date: 08/15/14 OPERATION PERMIT by: Justin Henderson Date: 8-22-14

AUTHORIZATION TO CONSTRUCT by: Robert H. Lowe Date: 08/15/14 Existing System Inspected by: Date:

Health Dept. Copy - WHITE Applicant (Final Approval) - YELLOW Applicant (Conditional Approval) - PINK