IREDELL COUNTY HEALTH DEPARTMENT

Statesville Phone TR 3-7271 Mooresville Phone NO 3-1271

PERMIT TO INSTALL SEPTIC TANK

Permit NO. 286 Permit Date Aug 26 1970

Owner Mr. Charles Miller Address Rt. 2 Stony Point, NC.

Installed By Lackey Bros. Address Stony Point, NC.


Location of Property West on Highway 90. to Scotts Turn Left on Road # 1537 - G. I. Tr. Trailer on Left.

Tank		Capacity		Length of Lines		Fixtures	
Block	( )	1000	(✓)	225'	(✓)	No. of Baths	(1)
Precast	(✓)	1250	( )	250'	( )	Dishwasher	( )
		1500	( )	Other		Garbage Grdr.	( )
		Other				Other	

NOTIFY HEALTH DEPARTMENT AT LEAST EIGHT HOURS BEFORE TANK IS TO BE INSPECTED.

Final Inspection Aug 26 1970 Approved (✓) Disapproved ( )

Remarks Water Supply From Neighbors House

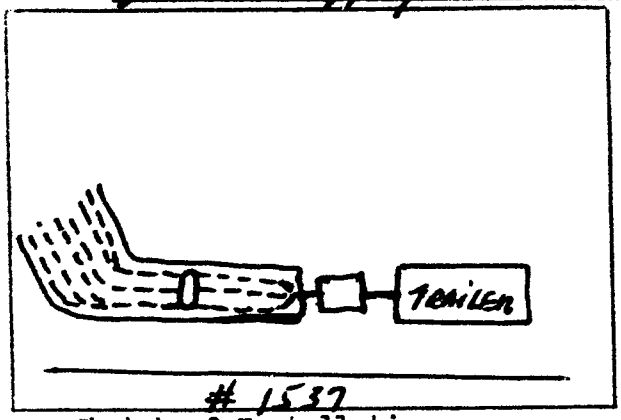

Sketch of Installation

Eleanor Lee Jr.

Sanitarian