IREDELL COUNTY HEALTH DEPARTMENT

Statesville Office (704) 878-5305 Mooresville Office (704) 660-3625 PERMIT # 219748

IMPROVEMENT PERMIT / AUTHORIZATION TO CONSTRUCT / OPERATION PERMIT / EXISTING SYSTEM

PIN # 3796-83-0749

APPLICANT: Custom Homes (Christopher Cranford) APPLICANT ADDRESS: 2026 Northside Dr. Statesville NC

SITE ADDRESS: 144 W. Lackey Farm Rd. Stony Point NC. PHONE: 704-873-2547 ALT. PHONE: 704-902-1983

SITE DIRECTIONS: Hwy 64 Toward Alexander Co. TL W. Lackey Farm, Site on R

SUBDIVISION: — SECTION: — LOT # — LOT AREA: 1.00 Acre DESIGN FLOW: 360 GPD. L.T.A.R.: .3 I / .1 R


Septic Tank	1000 (gal)	STB	760	Date	10-21	☑ New System ☐ Repair ☐ Expansion	System Type: I II (III) IV V VI	☑ Residence	No. Bedrooms 3
Pump Tank	(gal)	PT		Date		System Description:	25% Reduction - Gravity	☐ Business	No. Persons 6
Pump Make		Model		Serial #		Repair System Description:	Drip	☐ Other	No. Employees
# Nitrification Fields	1	# Lines	4	Linear Ft:	300'	Maintenance Agreement Required:	☐ YES ☑ NO	☐ Slab	☑ Crawl Space
Trench Width	36"	Max. Trench Bottom Depth	36"	Gravel Depth	N/A		☑ GRAVITY ☐ PRESSURE	☐ Basement w/plumbing	☐ Basement w/o plumbing

Water Supply: ☐ Private ☑ Public ☐ Community

Comments / Conditions: Smooth/Fill Any Rough Toes In Septic Area And/or 15' Around Septic Area. Serial Distribute Septic Lines. Follow All NC Septic Rules.

* Proposed Plat Must Be Recorded Prior To Issuance of AC. *

INITIAL SITE SKETCH

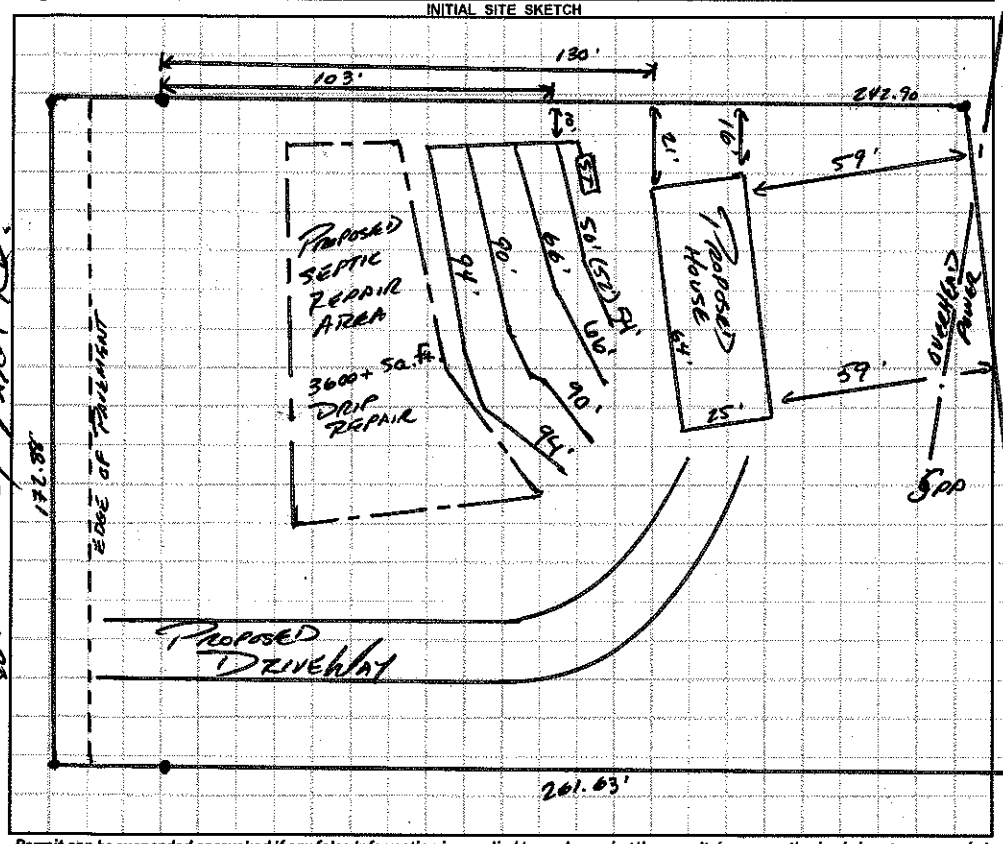

AS BUILT SKETCH

1" = 50'

INSTALLED AS SHOWN

304'

Permit can be suspended or revoked if any false information is supplied toward securing the permit / any unauthorized changes are made to the site / any unauthorized changes are made in the installation of the system. **CONTACT A LOCATOR SERVICE PRIOR TO ANY EXCAVATION**

☐ **IMPROVEMENT PERMIT** *with plat valid without expiration.* ☑ **IMPROVEMENT PERMIT** *with site plan valid for 60 mos.* ☐ **AUTHORIZATION TO CONSTRUCT** *valid for period equal to IMPROVEMENT PERMIT--not to exceed 60 mo.*

Owner / Applicant Signature: Date: 9/28/2016 Installed by:

IMPROVEMENT PERMIT by: APPROVED Date: JUN 28 2016 OPERATION PERMIT by: Date: 2-9-17

AUTHORIZATION TO CONSTRUCT by: Date: 10/25/16 Existing System Inspected by: Date:

Health Dept. Copy - WHITE Applicant (Final Approval) - YELLOW Applicant (Conditional Approval) - PINK