IREDELL COUNTY HEALTH DEPARTMENT

STATESVILLE 704-878-5305 SI MOORESVILLE 704-664-5281

IMPROVEMENT PERMIT / AUTHORIZATION TO CONSTRUCT / OPERATION PERMIT / EXISTING SYSTEM INSPECTION

PERMIT# 11259 PIN# 3796-86-3689 DATE 6/5/03

OWNER OR CONTRACTOR White Wolf Properties PHONE: Business (704) 532-6625 Home

ADDRESS 5551 Monroe Rd Charlotte N.C. 28212

LOCATION Hwy 64 W. (L) E. Lockey Farm Rd. (R) Cherry Blossom (L) Fairchase, Lot on the right

SUBDIVISION Fieldcrest BLOCK / SECTION II LOT 27 LOT AREA .97 Ac SITE CLASS. 45 DESIGN FLOW 480 L.T.A.R. .30

Septic Tank: 4,000 Gallons; STB 160 Date 6-20-03

Pump Tank: Gallons; PT Date

Pump Make: Model Equ. to Serial No.

Nitrification Field: No Fields 1 Square Feet 1600± Linear Feet 400

No Lines 5@80' Trench Width 36" Max Trench Bottom Depth Gravel Depth N/A

☒ New System ☐ Repair System Type: I, II, (III) IV, V, VI

System Description: Gravity 25% Reduction

Repair System Description: Gravity, 50% Reduction (Graywater Only)

Maintenance Agreement Required: ☐ Yes ☒ No

☐ House/Mod. Home ☒ Mobile Home ☐ Business ☐ Other

No. Bedrooms 4 No. Bathrooms 2 No. Employees

Water Supply: ☒ Individual ☐ Public ☐ Community

☐ Slab ☒ Crawl Space ☐ Basement w/plumbing ☐ Basement wo/plumbing


Comments:/Conditions: ① Keep well 100ft From Septic System ② Install lines on Contour ③ Do not install when wet ④ Keep Swimming pool 15 ft From Septic System

Comments:/Conditions:


Zabel filter + S.T. marker Installed

- Infiltrator Chambers Installed - 6/4

INITIAL SITE SKETCH 1"=50ft

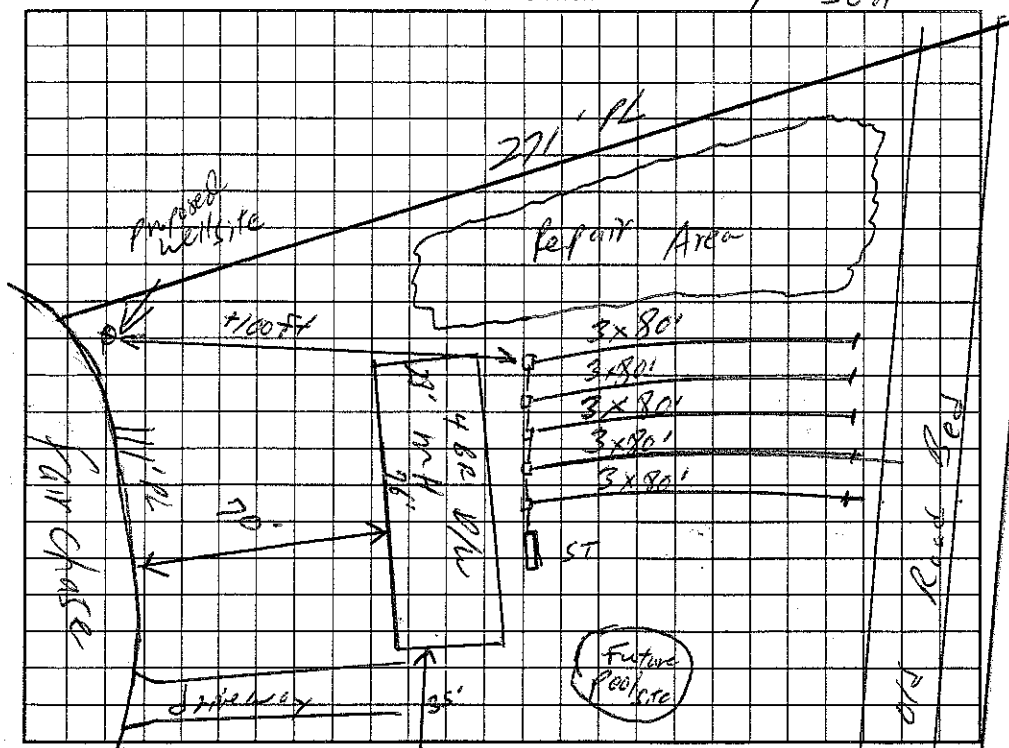

AS BUILT SKETCH

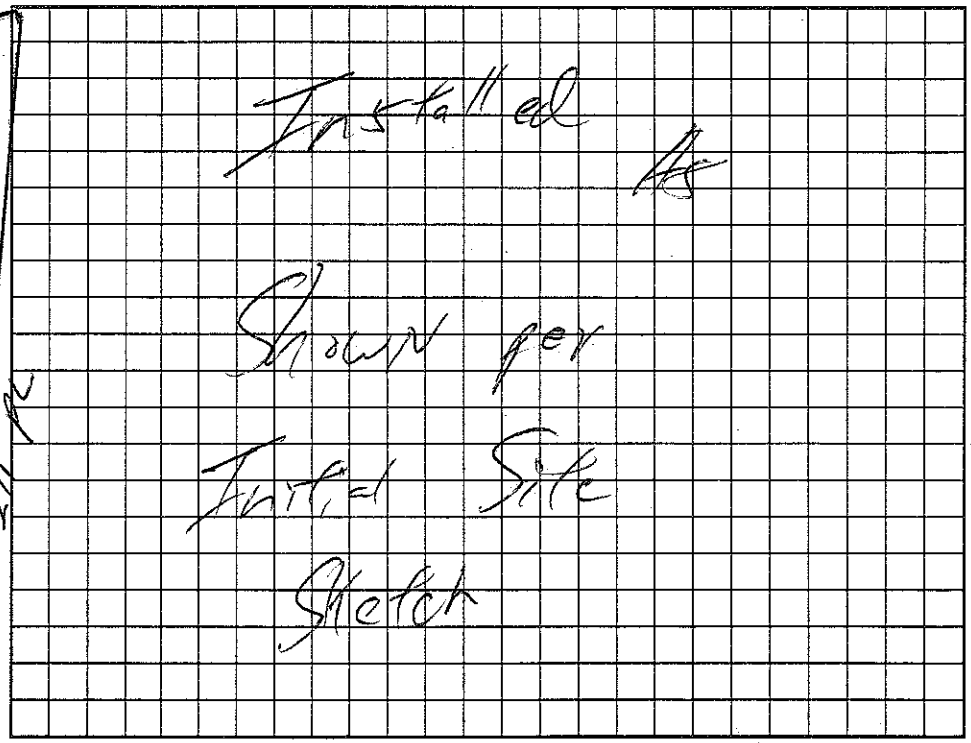

Permit can be suspended or revoked if any false information is supplied toward securing the permit/any unauthorized changes are made to the site/any unauthorized changes are made in the installation of the system. Improvement Permit with plat valid without expiration. Improvement Permit with site plan valid for sixty months. Authorization to Construct is valid for a period equal to that of Improvement Permit – not to exceed sixty months.

Signed: James J. McMenamy date 6/5/03

Improvement Permit by: William O. Johnson date 6/5/03

Authorization to Construct by: William O. Johnson date 6/5/03

Installed by: Tommy Cothren + Son

Operation Permit by: William O. Johnson date 7-29-03

Existing System Inspection by: date

HEALTH DEPT. COPY: WHITE OWNER COPY (FINAL): YELLOW OWNER COPY (INITIAL): PINK