Replaces Permit issued 20 May 08

IREDELL COUNTY HEALTH DEPARTMENT

STATESVILLE 704-878-5305 MOORESVILLE 704-664-5281

IMPROVEMENT PERMIT / AUTHORIZATION TO CONSTRUCT / OPERATION PERMIT / EXISTING SYSTEM INSPECTION

PERMIT# 150077 PIN# 5796-86-6125 DATE 10 July 08

OWNER OR APPLICANT Clayton Homes - Statesville PHONE: Business 704-873-2547 Home

ADDRESS 2026 Northside Drive Statesville

LOCATION Hwy 64 E Lackey Farm Rd. TR Sweet Chavvy Th Fair Chase LOT on RT.

SUBDIVISION Fieldcrest Crofts BLOCK / SECTION LOT 47 LOT AREA 0.72 Ac SITE CLASS P3 DESIGN FLOW 430gpd L.T.A.R. 0.3/FT²/d

Septic Tank: 1000g Gallons: STB 760 Date 7-1-08

Pump Tank: Gallons: PT Date

Pump Make: Model Serial No.

Nitrification Field: No Fields 1 Square Feet 1600 Linear Feet 400

No Lines 4 Trench Width 36" Max Trench Bottom Depth 36" Gravel Depth

☑ New System ☐ Repair ☐ Expansion System Type: I II III IV V VI

System Description: 25% Reduction

Repair System Description: 50% Reduction

Maintenance Agreement Required: ☐ Yes ☑ No

☑ Gravity ☐ Pressure ☐ Slab ☑ Crawl Space ☐ Basement w/plumbing ☐ Basement wo/plumbing

☑ House/Mod. Home No. Bedrooms 4

☐ Mobile Home No. Persons

☐ Business No. Employees

☐ Other

Water Supply: ☑ Individual ☐ Public ☐ Community

Comments:/Conditions:

Follow Contour
Hold Setback Requirements.

Comments:/Conditions:

Red Surface
Septic Marker

INITIAL SITE SKETCH

Please see Attached
10/09/08 Plan

AS BUILT SKETCH

Permit can be suspended or revoked if any false information is supplied toward securing the permit/any unauthorized changes are made to the site/any unauthorized changes are made in the installation of the system. Improvement Permit with plat valid without expiration ☐ Improvement Permit with site plan valid for sixty months ☑ Authorization to Construct is valid for a period equal to that of Improvement Permit – not to exceed sixty months.

Signed: date 7/11/08

Improvement Permit by: , R.S. date 10/6/08

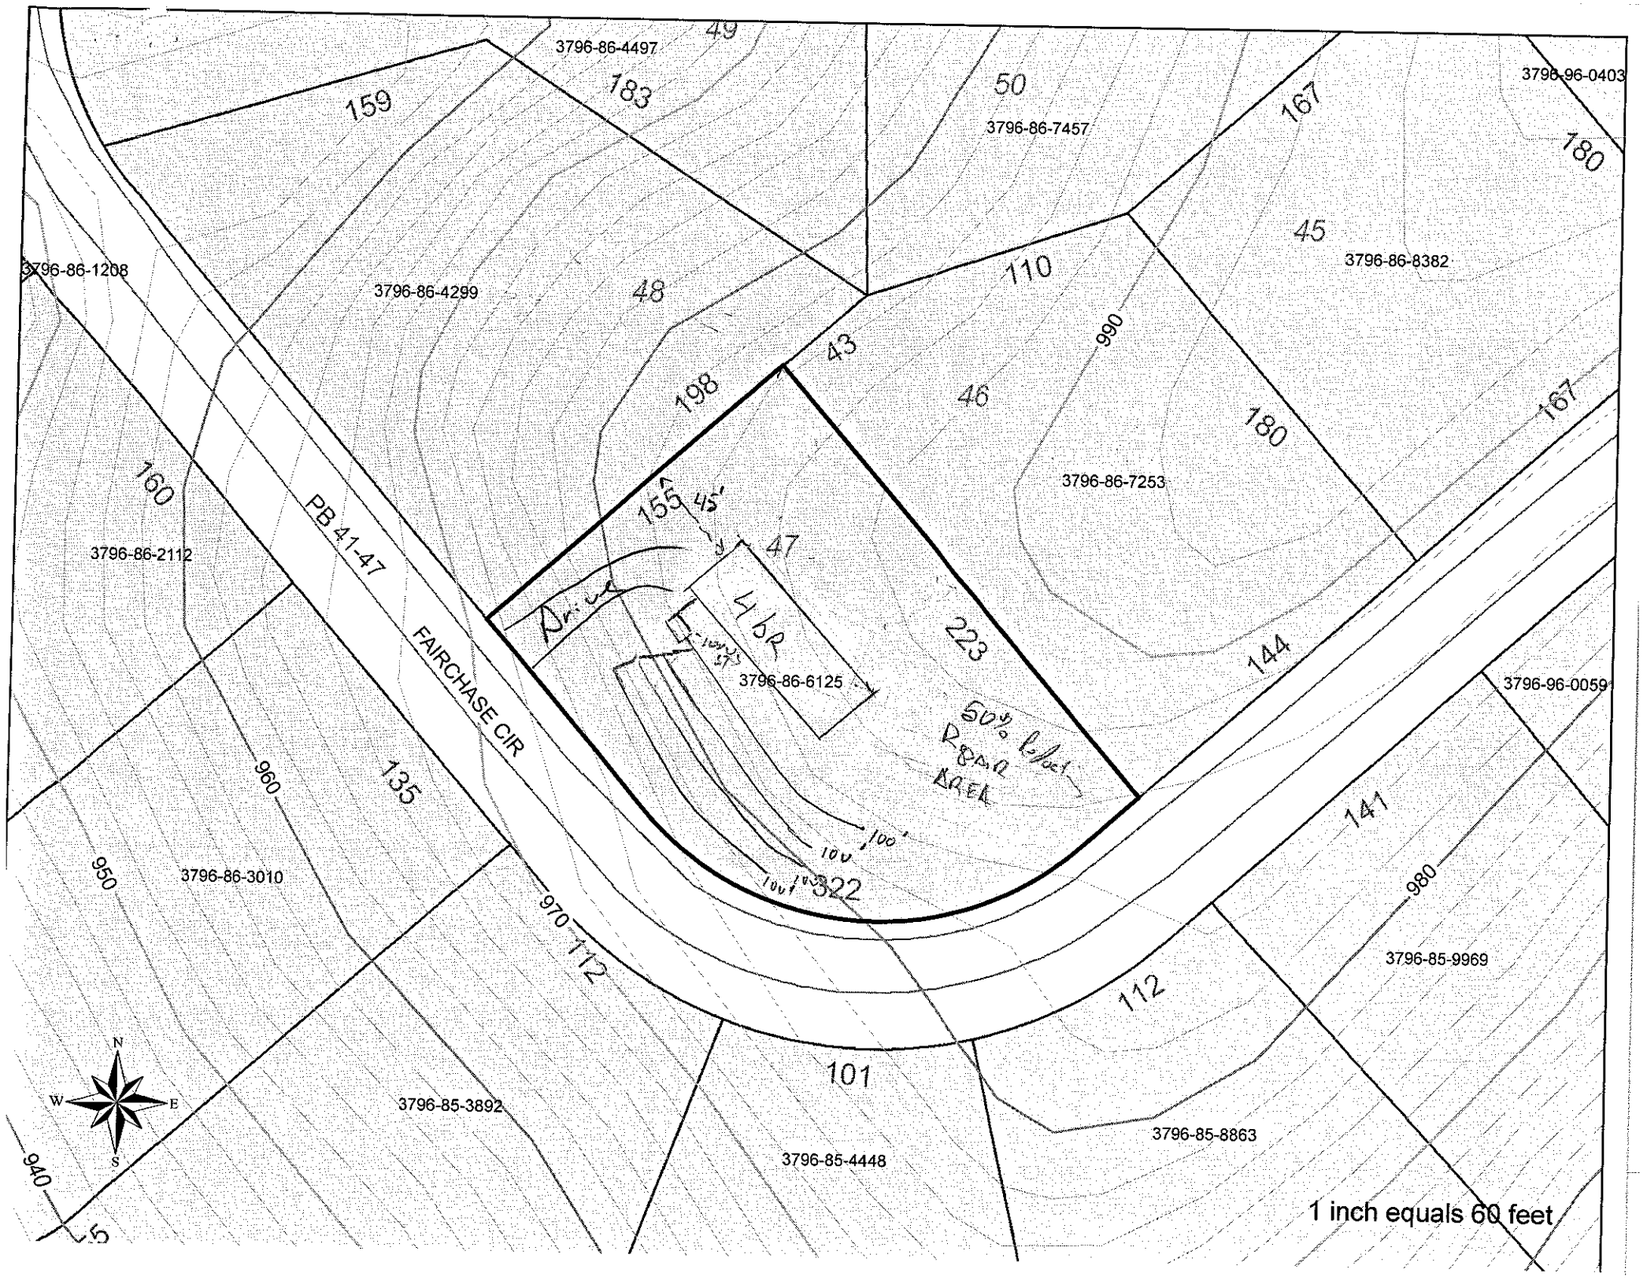
Authorization to Construct by: , R.S. date 10/6/08

Installed by: Hope Grading

Operation Permit by: date 7-15-08

Existing System Inspection by: date

HEALTH DEPT. COPY: WHITE OWNER COPY (FINAL): YELLOW OWNER COPY (INITIAL): PINK


3796-86-4497
49
159
183
50
3796-86-7457
167
3796-96-0403
180
45
3796-86-8382
3796-86-1208
3796-86-4299
48
110
43
990
198
46
180
167
160
PB 41-47
3796-86-7253
155
45'
47
3796-86-2112
Drive
4 BR
223
3796-86-6125
50% Lot
R-8MA
AREA
144
3796-96-0059
FAIRCHASE CIR
960
135
141
950
3796-86-3010
970
112
100'
322
980
112
3796-85-9969
101
N
W
E
S
3796-85-3892
3796-85-8863
940
3796-85-4448
1 inch equals 60 feet