FOR: AARON J. BURKE

IREDELL COUNTY HEALTH DEPARTMENT

STATESVILLE 704-878-5305 MOORESVILLE 704-664-5281

IMPROVEMENT PERMIT / AUTHORIZATION TO CONSTRUCT / OPERATION PERMIT / EXISTING SYSTEM INSPECTION

PERMIT# 076109 PIN# 3796 94 7762 DATE 8.27.98

OWNER OR CONTRACTOR KENNETH CONE PHONE: Business Home 585-4665

ADDRESS 47 TOLEDO, STONY POINT, NC 28678

LOCATION US 64 WEST, TL LACKEY FARM ROAD EAST, TR CHERRY BLOSSOM LANE, 0.3 MILE ON LEFT

SUBDIVISION RICHMOND HILLS BLOCK / SECTION LOT 09 LOT AREA 1.962 ACRES SITE CLASS. PS DESIGN FLOW 360 L.T.A.R. 0.30 GPD/FT²

Septic Tank: 1000 Gallons; STB 1007 Date 4.2.99
Pump Tank: Gallons; PT Date
Pump Make: Model Serial No.
Nitrification Field: No Fields 1 Square Feet 1200 Linear Feet 400
No Lines EIGHT Trench Width 36" Max Trench Bottom Depth 36" Gravel Depth 12"

☑ New System ☐ Repair System Type: I, II, III, IV, V, VI
System Description: CONVENTIONAL GRAVITY
Repair System Description: CONV. GRAVITY
Maintenance Agreement Required: ☐ Yes ☑ No
☐ Slab ☑ Crawl Space ☑ Basement w/plumbing ☐ Basement wo/plumbing


☑ House/Mod. Home No. Bedrooms 3
☐ Mobile Home No. Bathrooms 2
☐ Business No. Employees
☐ Other

Water Supply: ☑ Individual ☐ Public ☐ Community
WELL

Comments:/Conditions: ① USE ONE FLOW DIVIDER TEE TO ACHIEVE EQUAL DISTRIBUTION INTO TWO SETS OF DRAINLINES OF FOUR LINES EACH USING DROP BOXES FOR SERIAL DISTRIBUTION ② KEEP SYSTEM MINIMUM 100' FROM WELL.

Comments:/Conditions: ① SEPTIC TANK LESS THAN 28 DAYS OLD - TESTED ~3500PSI W/ SCHMIDT REBOUND HAMMER ② SYSTEM INSTALLED ACCORDING TO INITAL SITE SKETCH

INITIAL SITE SKETCH SCALE: 1" = 60'

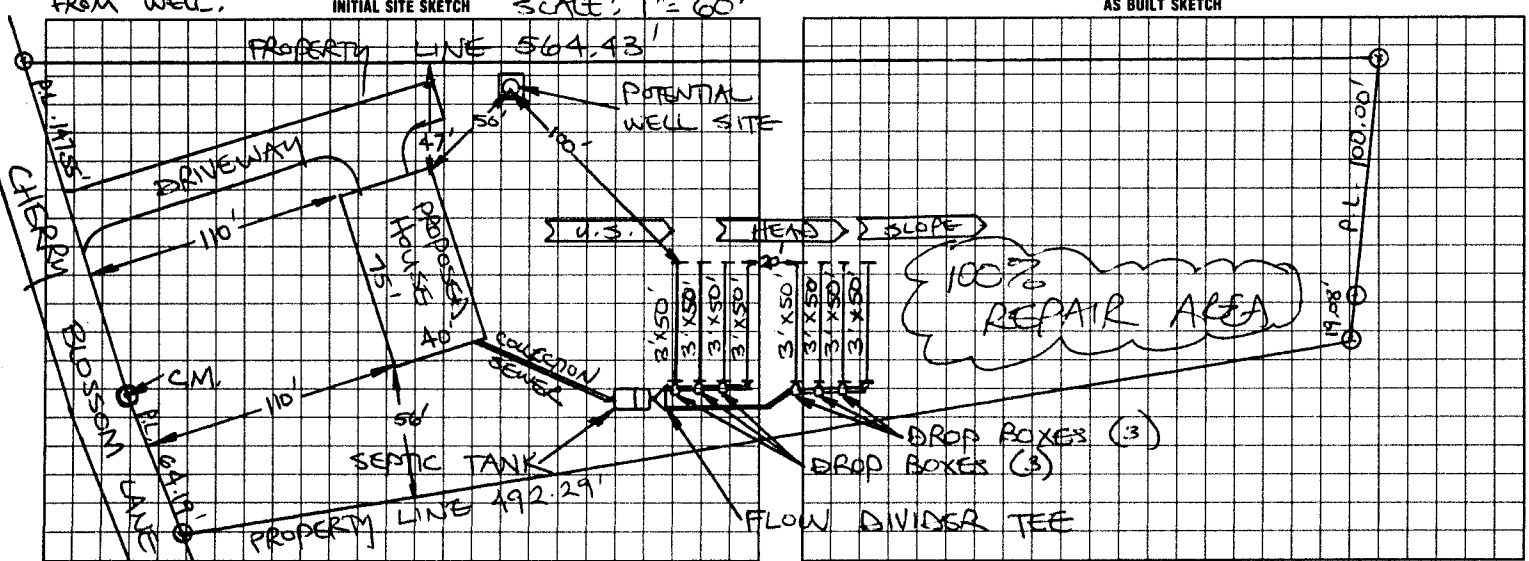

AS BUILT SKETCH

I understand that this permit can be suspended or revoked if any false information is supplied toward securing the permit/any unauthorized changes are made to the site/any unauthorized changes are made in the installation of the system. Improvement Permit with plat valid without expiration. Improvement Permit with site plan valid for sixty months. Authorization to Construct is valid for a period equal to that of Improvement Permit – not to exceed sixty months.

Signed: Aaron J. Burke date 2/4/1678

Improvement Permit by: STEVE HEDRICK date 8-27-98

Authorization to Construct by: STEVE HEDRICK date 8.27.98

Installed by: SCOTT GREENE

Operation Permit by: STEVE HEDRICK date 4.20.99

Existing System Inspection by: date

HEALTH DEPT. COPY: WHITE INSPECTION COPY (FINAL): GREEN OWNER COPY (FINAL): YELLOW INSPECTION COPY (INITIAL): PINK OWNER COPY (INITIAL): GOLD