IREDELL COUNTY HEALTH DEPARTMENT

STATESVILLE 704-878-5305 MOORESVILLE 704-664-5281

IMPROVEMENT PERMIT / AUTHORIZATION TO CONSTRUCT / OPERATION PERMIT / EXISTING SYSTEM INSPECTION

PERMIT # 156709 PIN # 3796-96-1760 DATE 9 June 09

OWNER or APPLICANT White Wolf Properties / Clayton Homes PHONE: Business (704) 873-2547 Home:

OWNER or APPLICANT ADDRESS 2026 Northside Dr. Statesville, N.C.

LOCATION / DIRECTIONS Hwy 64 W TL Lackey Farm Rd. TR Sweet Chevy

SUBDIVISION Fieldcroft BLOCK / SECTION 3 LOT # 58 LOT AREA DESIGN FLOW 360 g/d L.T.A.R. 0.3 g/ft²/d

Septic Tank 1000 g Gallons: STB 760 Date 2-18-09
Pump Tank Gallons: P T Date
Pump Make Model Serial #
Nitrification Field No Fields 1 No Lines 9 Linear Feet 300
Trench Width 36" Max. Trench Bottom Depth 36" Gravel Depth N/A

☑ New System ☐ Repair ☐ Expansion System Type I II III IV V VI
System Description: 25% Reduction System
Repair System Description: 50% Reduction Syst...
Maintenance Agreement Required ☐ YES ☒ NO
☑ GRAVITY ☐ PRESSURE

☑ Residence No. Bedrooms 3
☐ Business No. Persons
☐ Other No. Employees
☐ Slab ☑ Crawl Space
☐ Basement w/plumbing ☐ Basement w/o plumbing

Water Supply
☑ Private
☐ Public
☐ Community

Comments / Conditions: Follow contour / Keep upslope / Honor setbacks.

Comments / Conditions: Fill installed.

INITIAL SITE SKETCH

Please see attached site sketch.

AS BUILT SKETCH

Installed as Drawn

Permit can be suspended or revoked if any false information is supplied toward securing the permit / any unauthorized changes are made to the site / any unauthorized changes are made in the installation of the system.

☐ *IMPROVEMENT PERMIT w / plat valid without expiration* ☑ *IMPROVEMENT PERMIT w / site plan valid for 60 mos.* ☑ *AUTHORIZATION TO CONSTRUCT valid for period equal to IMPROVEMENT PERMIT-not to exceed 60 mo.*

Owner / Applicant Signature: Date 6/15/09

Improvement Permit by: R.S. Date 9 June 09

Authorization to Construct by: R.S. Date 30 June 09

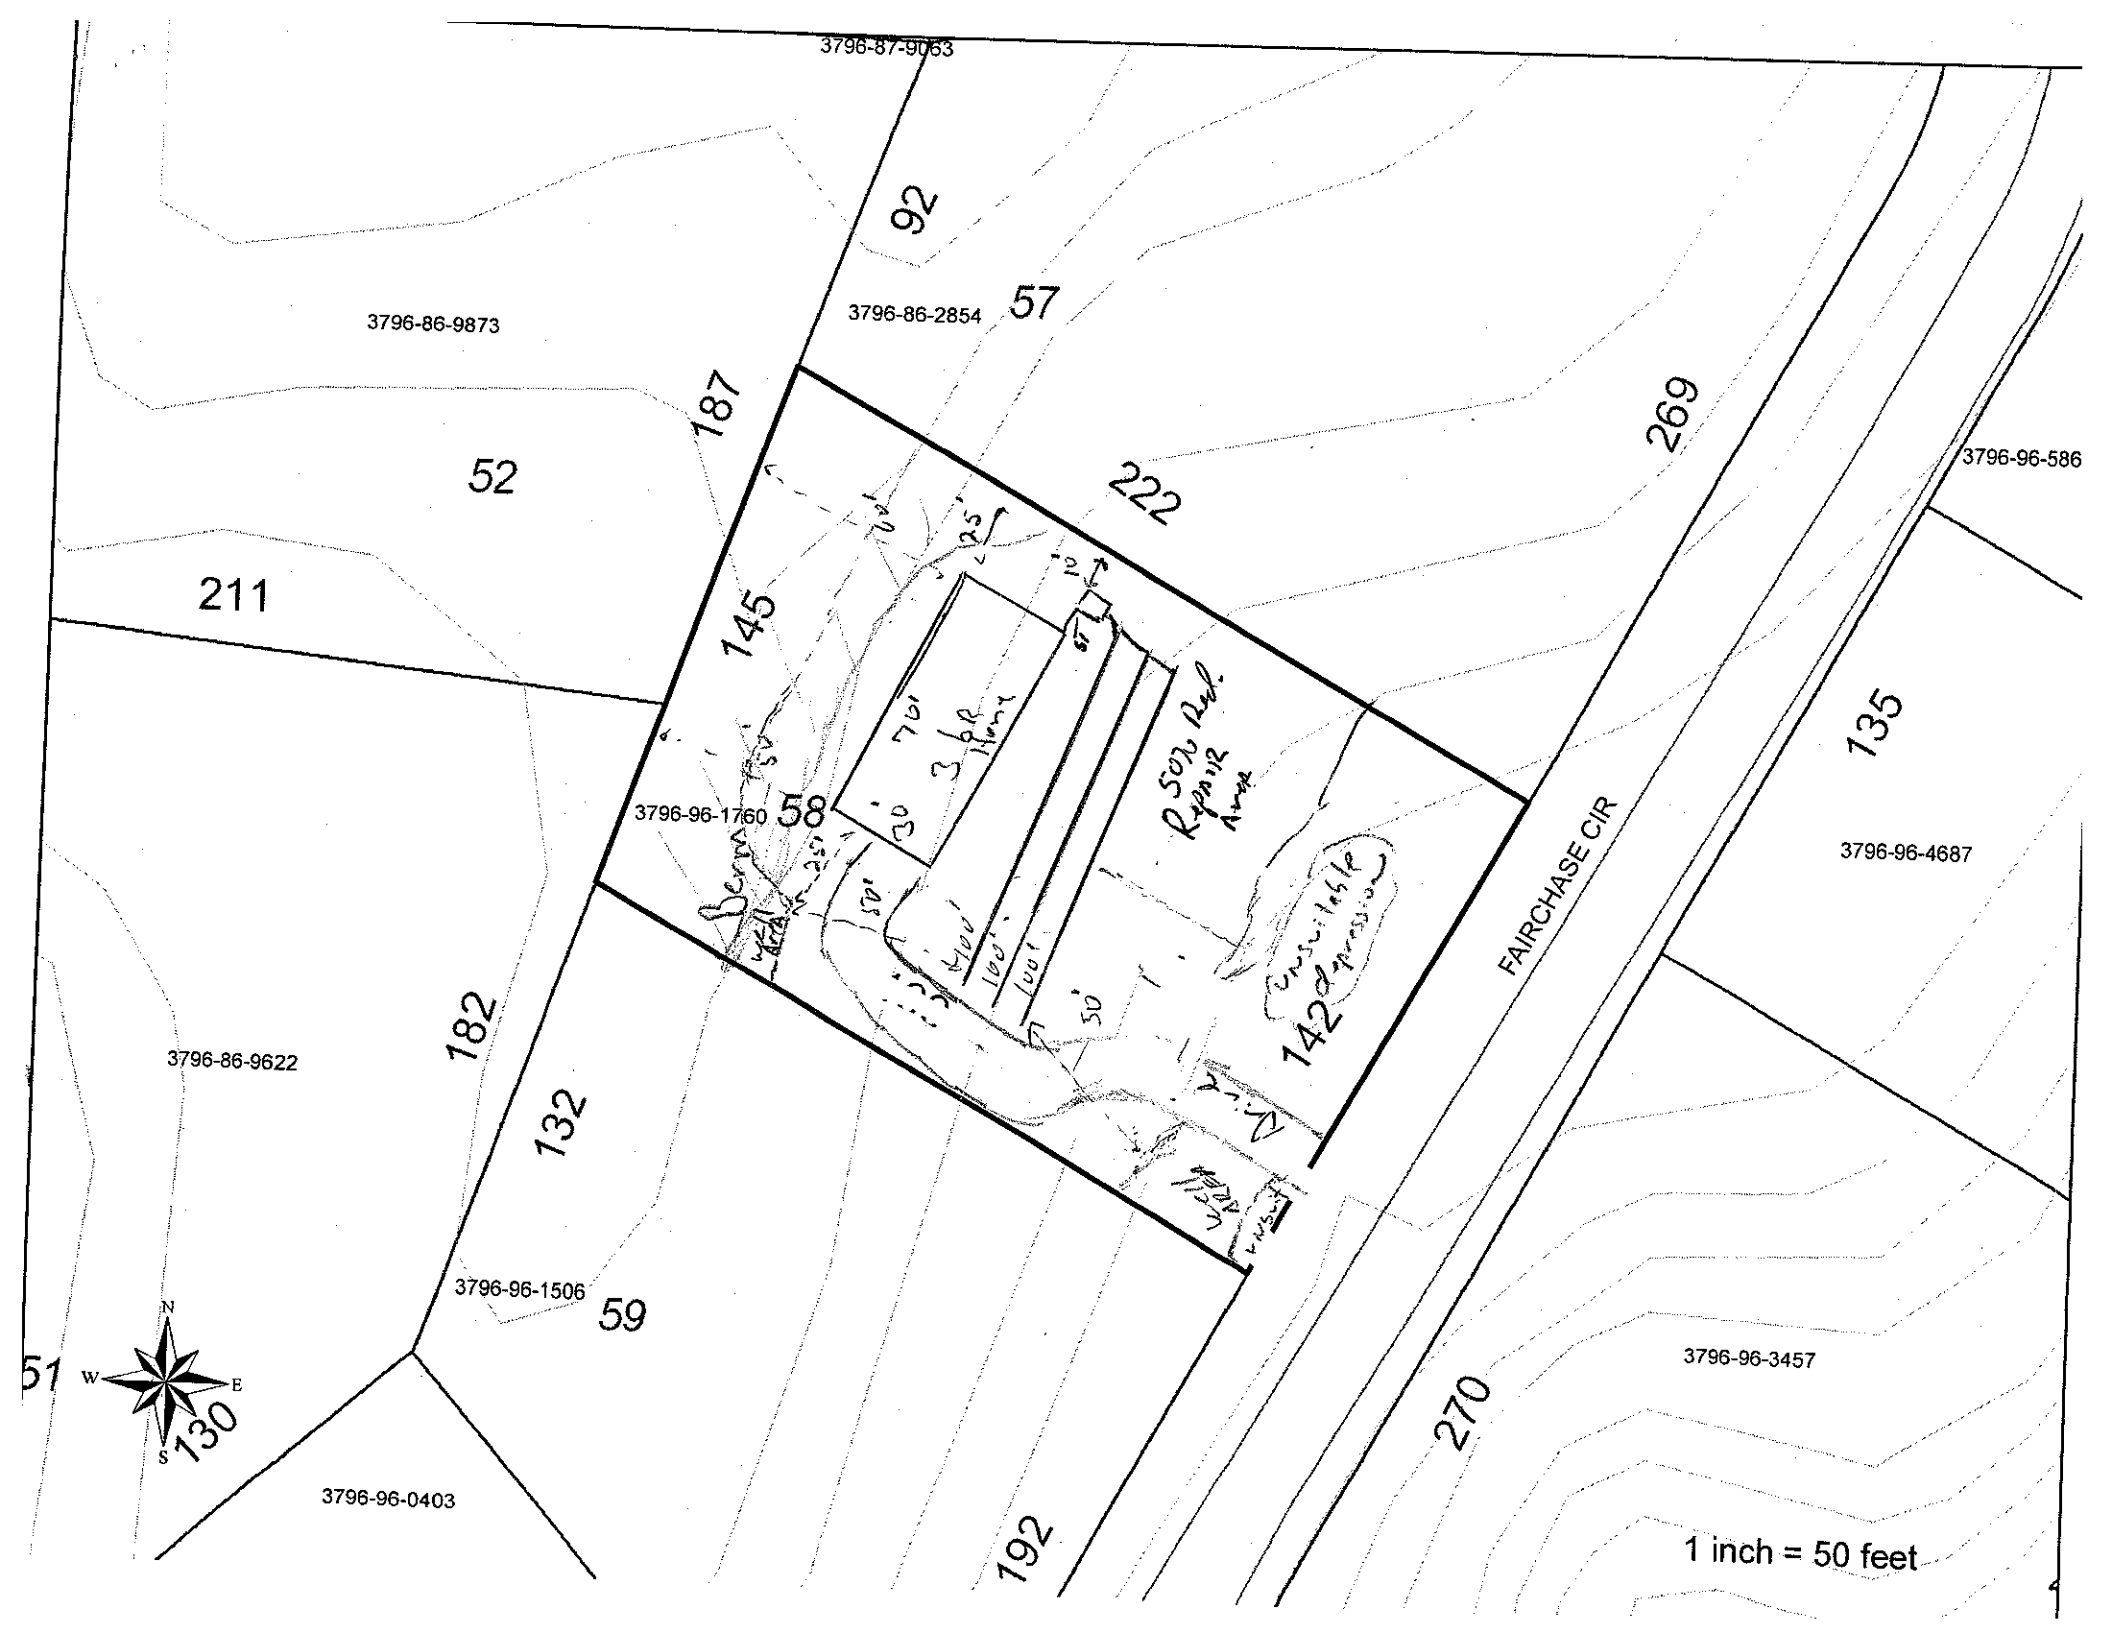
Installed by: Tim

Operation Permit by: R.S. Date: 30 June 09

Existing System Inspected by: Date:

YOU SHOULD CONTACT A LOCATOR SERVICE PRIOR TO ANY EXCAVATION.

WHITE COPY Environmental Health YELLOW COPY (Final) Owner / Applicant PINK COPY (Initial) Owner / Applicant


3796-87-9063
92
3796-86-2854
57
3796-86-9873
187
269
52
22
3796-96-586
211
145
135
3796-96-1760
58
3796-96-4687
FAIRCHASE CIR
182
132
142
3796-86-9622
3796-96-1506
59
N
W
E
S
130
3796-96-0403
3796-96-3457
270
192
1 inch = 50 feet