IREDELL COUNTY HEALTH DEPARTMENT

*PERMIT REPLACES ONE ISSUED 8-19-02, NOW VOID

STATESVILLE 704-878-5305 MOORESVILLE 704-664-5281

IMPROVEMENT PERMIT / AUTHORIZATION TO CONSTRUCT / OPERATION PERMIT / EXISTING SYSTEM INSPECTION

PERMIT# 106240 PIN# 3796-96-7138 DATE 2-9-05

OWNER OR CONTRACTOR WHITE WOLF PROPERTIES PHONE: Business (704) 532-6527 Home

ADDRESS 5551 MONROE ROAD CHARLOTTE NC 28212

LOCATION US 64 W TL LACKEY FARM RD TR CHERRY BLOSSOM TR SWEET CHERRY 3RD LOT ON RIGHT

SUBDIVISION FIELDCROFT BLOCK / SECTION I LOT 14 LOT AREA 0.99 SITE CLASS. PS DESIGN FLOW 360 L.T.A.R. 0.30 gpd/ft²

Septic Tank: 1000 Gallons; STB 794 Date 1-7-05

Pump Tank: Gallons; PT Date

Pump Make: Model Serial No.

Nitrification Field: No Fields 1 Square Feet 1200 Linear Feet 400'

No Lines 3 Trench Width 36" Max Trench Bottom Depth 30" Gravel Depth 12"

☑ New System ☐ Repair System Type: I (II) III, IV, V, VI

System Description: CONVENTIONAL GRAVITY

Repair System Description: PUMP 25% REDUCTION

Maintenance Agreement Required: ☐ Yes ☑ No

☑ House/Mod. Home No. Bedrooms 3

☐ Mobile Home No. Bathrooms

☐ Business No. Employees

☐ Other


☐ Slab ☑ Crawl Space ☐ Basement w/plumbing ☐ Basement wo/plumbing

Water Supply: ☑ Individual ☐ Public ☐ Community

Comments:/Conditions: ① INSTALL LINES ON CONTOUR ② MAINTAIN ALL SETBACKS

Comments:/Conditions: ① RED "POLYLOK" FILTER ② 6" RISER ON TANK ③ #5 STONE ④ D-BOXES W/ SPEED LEVELERS ON OUTLET FOR DROP BOXES

INITIAL SITE SKETCH * 1" = 60'

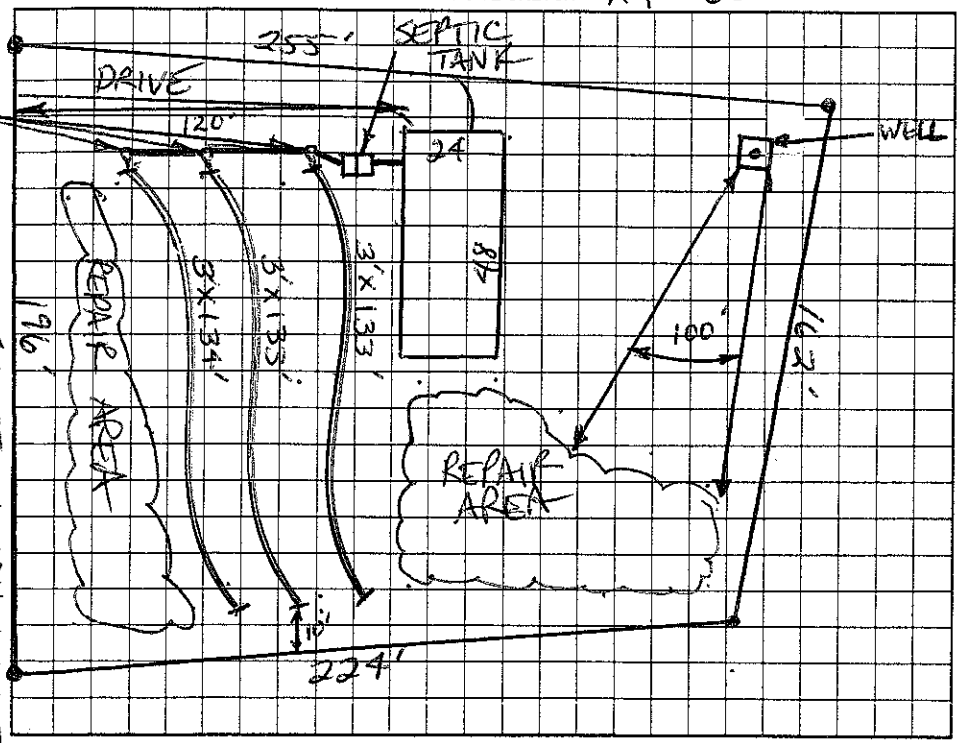

AS BUILT SKETCH

*SYSTEM INSTALLED ACCORDING TO INITIAL SITE SKETCH

Permit can be suspended or revoked if any false information is supplied toward securing the permit/any unauthorized changes are made to the site/any unauthorized changes are made in the installation of the system. Improvement Permit with plat valid without expiration; Improvement Permit with site plan valid for sixty months. Authorization to Construct is valid for a period equal to that of Improvement Permit – not to exceed sixty months.

Signed: date 2/16/05 Installed by: SPECIALTY SEPTIC

Improvement Permit by: Christopher M. Shuler RS, LSS date 2-9-05 Operation Permit by: Christopher M. Shuler RS, LSS date 2-16-05

Authorization to Construct by: Christopher M. Shuler RS, LSS date 2-16-05 Existing System Inspection by: date

HEALTH DEPT. COPY: WHITE OWNER COPY (FINAL): YELLOW OWNER COPY (INITIAL): PINK