IREDELL COUNTY HEALTH DEPARTMENT

Statesville Office (704) 878-5305 Mooresville Office (704) 660-3625 PERMIT # 213064

IMPROVEMENT PERMIT / AUTHORIZATION TO CONSTRUCT / OPERATION PERMIT / EXISTING SYSTEM

PIN # 3796972383

APPLICANT: Clayton Homes APPLICANT ADDRESS: 2026 Northside Dr Statesville NC 28625

SITE ADDRESS: 239 Fairchase Cir Stony Point NC PHONE: 704-873-2547 ALT. PHONE: 704-677-8903

SITE DIRECTIONS: 40 W T/R Hwy 64 R/L E Lacky T/R Sweet Cherry T/R Fairchase Cir Lot on right


SUBDIVISION: Fieldcroft SECTION: P2 LOT # 37 LOT AREA: .690 ac DESIGN FLOW: 360 L.T.A.R.: 0.3

Septic Tank	1000 (gal)	STB	760	Date	8-18-15	☒ New System	☐ Repair	☐ Expansion	System Type: I II ☒ III IV V VI	☒ Residence	No. Bedrooms 3
Pump Tank	N/A (gal)	PT	N/A	Date	N/A	System Description:	25% Reduction			☐ Business	No. Persons 6
Pump Make	N/A	Model	Poly/Lok	Serial #	PL-6T	Repair System Description:	50% Reduction			☐ Other	No. Employees
# Nitrification Fields	1	# Lines	3	Linear Ft:	300	Maintenance Agreement Required:	☐ YES	☒ NO		☐ Slab	☒ Crawl Space
Trench Width	36"	Max. Trench Bottom Depth	36"	Gravel Depth	N/A		☒ GRAVITY	☐ PRESSURE		☐ Basement w/plumbing	☐ Basement w/o plumbing

Water Supply: ☒ Private ☐ Public ☐ Community

Comments / Conditions: Install 25% reduction on contour with serial distribution. Maintain 36" trench depth on high side.

INITIAL SITE SKETCH

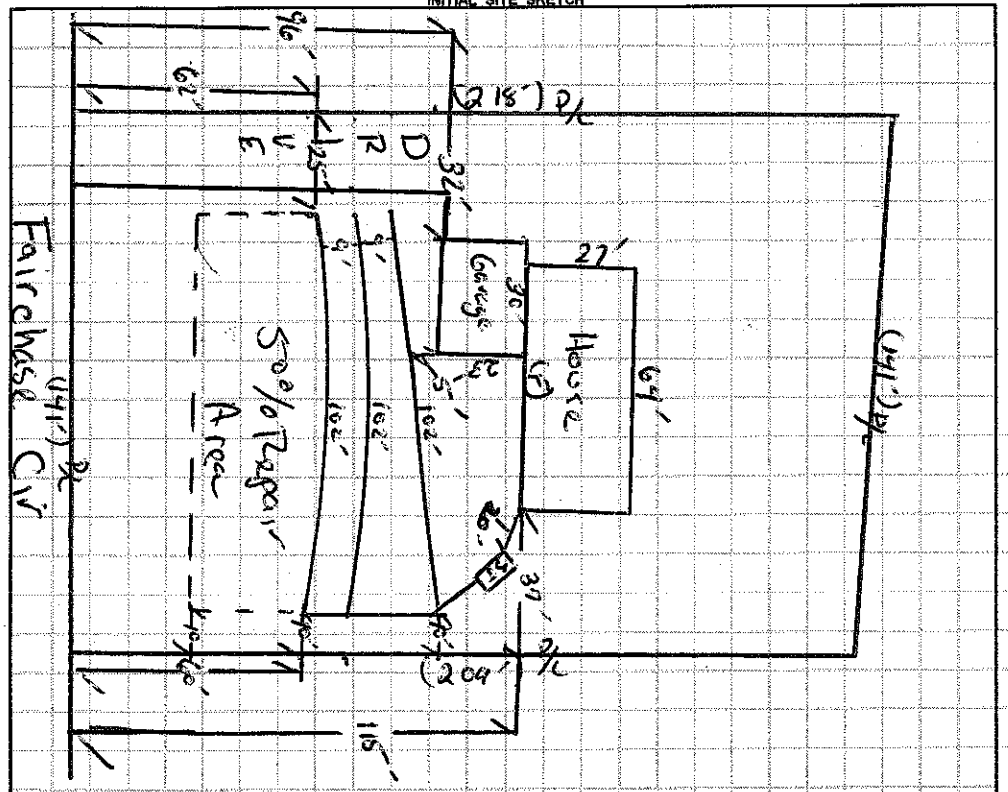

AS BUILT SKETCH

1" = 50

Installed Quick as drawn

Permit can be suspended or revoked if any false information is supplied toward securing the permit / any unauthorized changes are made to the site / any unauthorized changes are made in the installation of the system. **CONTACT A LOCATOR SERVICE PRIOR TO ANY EXCAVATION**

☐ **IMPROVEMENT PERMIT** *with plat valid without expiration* ☒ **IMPROVEMENT PERMIT** *with site plan valid for 60 mos.* ☒ **AUTHORIZATION TO CONSTRUCT** *valid for period equal to IMPROVEMENT PERMIT--not to exceed 60 mo.*

Owner / Applicant Signature: Date: 9/29/15 Installed by: Ground breakers

IMPROVEMENT PERMIT by: Date: 09/25/15 OPERATION PERMIT by: Date: 01/13/16

AUTHORIZATION TO CONSTRUCT by: Date: 09/25/15 Existing System Inspected by: Date:

Health Dept. Copy - WHITE Applicant (Final Approval) - YELLOW Applicant (Conditional Approval) - PINK