473 41

IREDELL COUNTY HEALTH DEPARTMENT

STATESVILLE 704-878-5305 MOORESVILLE 704-664-5281

IMPROVEMENT PERMIT / CERTIFICATE OF COMPLETION / OPERATION PERMIT / EXISTING SYSTEM INSPECTION

Watershed: ☐ Yes ☑ No

PROPERTY DESCRIPTION NO. 16014 DATE 12-1-93 TAX MAP NO. 9J-B-51

OWNER OR CONTRACTOR Leroy Babcock PHONE: Business Home 595-9120

ADDRESS

LOCATION I40W TR Hwy 90 TL 1st entrance Lacky Farm Rd. Lot on R approx .2 miles.

SUBDIVISION NA BLOCK / SECTION — LOT — LOT AREA 16.0 acres SITE CLASS. P.S. DESIGN FLOW 360 L.T.A.R. .35 gpd/ft²

Septic Tank: 1000 Gallons; STB 1012 Date 9-21-93

Pump Tank: — Gallons; PT — Date —

Pump Make: — Model — Serial No. —

Nitrification Field: No Fields 1 Square Feet 1035 Linear Feet 345

No Lines 3 Trench Width 36" Max Trench Bottom Depth 36" Gravel Depth 12"

☑ New System ☐ Repair System Type: I, II, III, IV, V, VI

System Description: Conventional, gravity Fed.

Repair System Description: " "

Maintenance Agreement Required: ☐ Yes ☑ No

☑ House/Mod. Home ☐ Mobile Home ☐ Business ☐ Other

No. Bedrooms 3 No. Bathrooms 2.5 No. Employees —

☐ Slab ☐ Crawl Space ☑ Basement w/plumbing ☐ Basement wo/plumbing


Water Supply: ☐ Individual ☐ Community ☑ Public

Comments:

Comments: Retaining wall at basement side caused system to be moved further from home. 100% Repair area further into pasture. Recommended not to drive over septic system. Keep water line min. 10' from any part of septic system

INITIAL SITE SKETCH

AS BUILT SKETCH

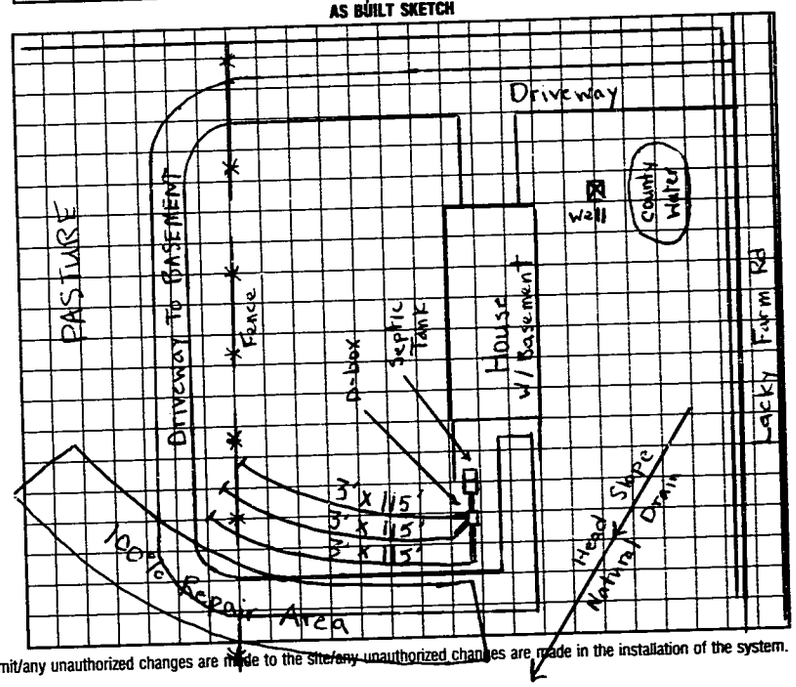

I understand that this permit can be suspended or revoked if any false information is supplied toward securing the permit/any unauthorized changes are made to the site/any unauthorized changes are made in the installation of the system. Improvement Permit is valid for 60 months from date of issuance.

Signed:

Improvement Permit by: Michael J. Dennis date 3-30-93

Existing System Inspection by: date

Installed by: Tommy Catheron

Certificate of Completion by: Michael J. Dennis date 12-1-93

Operation Permit by: date

HEALTH DEPT. COPY: WHITE INSPECTION COPY (FINAL): GREEN OWNER COPY (FINAL): YELLOW INSPECTION COPY (INITIAL): PINK OWNER COPY (INITIAL): GOLD