IREDELL COUNTY HEALTH DEPARTMENT

STATESVILLE 704-878-5305 MOORESVILLE 704-664-5281

IMPROVEMENT PERMIT / AUTHORIZATION TO CONSTRUCT / OPERATION PERMIT / EXISTING SYSTEM INSPECTION

PERMIT# REPAIR PIN# 3797 50 5728 DATE 2-20-01

OWNER OR CONTRACTOR GREG LACKEY PHONE: Business Home 585-2772

ADDRESS 115 GREG LANE STONY POINT NC 28678

LOCATION US 64 W, TL W. LACKEY FARM RD, TR GREG LANE, LOT ON LEFT

SUBDIVISION BLOCK / SECTION LOT 7 LOT AREA 1.23 ACRES SITE CLASS PS DESIGN FLOW 360 L.T.A.R. EXISTING

Septic Tank: EXISTING Gallons; STB Date

Pump Tank: Gallons; PT Date

Pump Make: Model Serial No

Nitrification Field: No Fields 2 Square Feet 480 Linear Feet 160

No Lines TWO Trench Width 36" Max Trench Bottom Depth 40" Gravel Depth 24"

☐ New System ☑ Repair System Type: I (II) III, IV, V, VI

System Description:

Repair System Description: CONV. GRAVITY

Maintenance Agreement Required: ☐ Yes ☑ No

☐ Slab ☑ Crawl Space ☐ Basement w/plumbing ☐ Basement wo/plumbing

☐ House/Mod. Home No. Bedrooms 3

☑ Mobile Home No. Bathrooms 2

☐ Business No. Employees


☐ Other

Water Supply: ☐ Individual ☑ Public ☐ Community

Comments/Conditions: ① EXCAVATE EXISTING DRAINFIELD MINIMUM 15' FEET FROM TOP of EMBANKMENT & PACK W/ RED CLAY ② INSTALL TWO NEW DRAINLINES AS FLAGGED ON CONTOUR USING 24" STONE ③ USE DROP BOXES AS SHOWN

Comments/Conditions

INITIAL SITE SKETCH

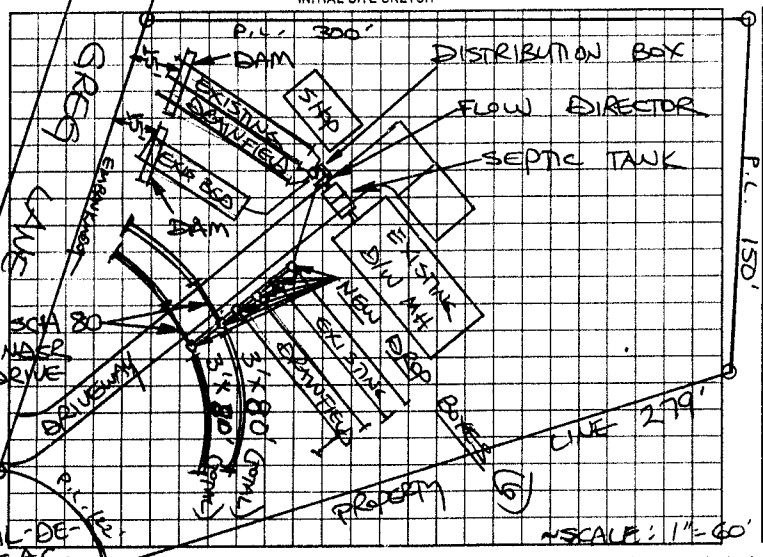

AS BUILT SKETCH

SYSTEM REPAIRED ACCORDING TO INITAL SITE SKETCH

Permit can be suspended or revoked if any false information is supplied toward securing the permit/any unauthorized changes are made to the site/any unauthorized changes are made in the installation of the system. Improvement Permit with plan valid without expiration. Improvement Permit with site plan valid for sixty months. Authorization to Construct is valid for a period equal to that of Improvement Permit – not to exceed sixty months.

Signed: date 3-16-01 Installed by: ANDY DANIELS

Improvement Permit by: STEVE HEDRICK date 2-20-01 Operation Permit by: STEVE HEDRICK date 5-24-01

Authorization to Construct by: STEVE HEDRICK date 2-20-01 Existing System Inspection by: date

HEALTH DEPT COPY: WHITE OWNER COPY (FINAL): YELLOW OWNER COPY (INITIAL): PINK