not located

# IREDELL COUNTY HEALTH DEPARTMENT

STATESVILLE 704-878-5305 MOORESVILLE 704-664-5281

## IMPROVEMENT PERMIT / CERTIFICATE OF COMPLETION / OPERATION PERMIT / EXISTING SYSTEM INSPECTION

PROPERTY DESCRIPTION NO. 16802 DATE 9-17-93 TAX MAP NO. 9J-4-A-5

OWNER OR CONTRACTOR Billy Miller PHONE: Business Home

ADDRESS P.O. Box 6162 Statesville, N.C. 28677

LOCATION Hwy 90W Tl 2nd Entrance Lackey Farm Rd. TR Emerald Lane, Last lot on R.

SUBDIVISION Green Valley BLOCK / SECTION LOT 5 LOT AREA 150' x 200' SITE CLASS P.S. L.T.A.R. .35 gpd / ft²

Water Supply: ☐ Individual ☐ Community ☑ Public county water

Septic Tank: 1000 Gallons: STB 1012 Date 8-19-93

Pump Tank: — Gallons: PT — Date —

Nitrification Field: No Fields 1 Square Feet 690 Linear Feet 230'

No Lines 2 Trench Width 36" Trench Depth 18"-24" Gravel Depth 12"

☑ New System ☐ Repair System Type: I, II, III, IV, V, VI

System Description: conventional, gravity

Repair System Description: "

Maintenance Agreement Required: ☐ Yes ☑ No

☐ House/Mod. Home ☑ Mobile Home ☐ Business ☐ Other

No. Bedrooms 2 No. Bathrooms 2 No. Employees —

☐ Slab ☑ Crawl Space ☐ Basement w/plumbing

Garbage Disposal: ☐ Yes ☑ No

Auto. Dishwasher: ☑ Yes ☐ No


Auto. Washing Machine: ☑ Yes ☐ No

Other

☐ Basement wo/plumbing

Comments INSTALL SYSTEM SHALLOW (no deeper than 24" to trench bottom) Keep Nitrification Lines on contour. Keep system 5' min. from foundation of home, 10' from all property lines, and 10' from water line. Keep system 10' at gulley. 100% Repair Area below system, conventional, gravity fed.

INITIAL SITE SKETCH

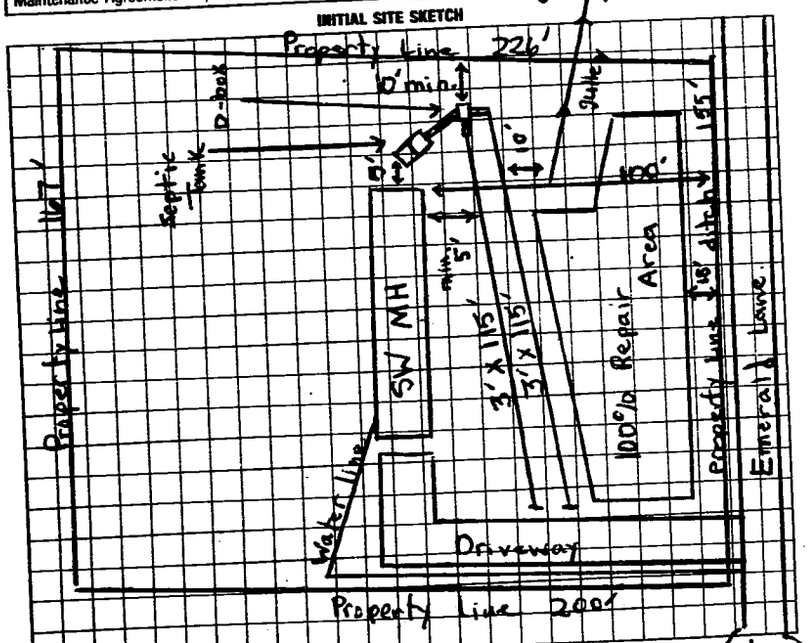


AS BUILT SKETCH

* M.H. not located on lot at time of inspection; Keep home min. 5' from any part of septic system.
* Well also not located at time of inspection. If well is used, keep min. 50' from any part of septic system. Public water supposed to be used.
* Keep water line min. 10' from any part of septic system.

SAME AS INITIAL SKETCH

I understand that this permit can be suspended or revoked if any false information is supplied toward securing the permit/any unauthorized changes are made to the site/any unauthorized changes are made in the installation of the system. Improvement Permit is valid for 60 months from date of issuance.

Signed: X Bill Miller date 9-17-93

Improvement Permit by: Michael G. Dennis date

Existing System Inspection by: date

Installed by: Forest Shuford. date 10-20-93

Certificate of Completion by: Michael G. Dennis date

Operation Permit by: date

HEALTH DEPT. COPY: WHITE INSPECTION COPY (FINAL): GREEN OWNER COPY (FINAL): YELLOW INSPECTION COPY (INITIAL): PINK OWNER COPY (INITIAL): GOLD