IREDELL COUNTY HEALTH DEPARTMENT

STATESVILLE 704-878-5305 MOORESVILLE 704-664-5281

IMPROVEMENT PERMIT / AUTHORIZATION TO CONSTRUCT / OPERATION PERMIT / EXISTING SYSTEM INSPECTION

PERMIT# 089805 PIN# 3797 52 3613 (PT) DATE 6-14-2000

OWNER OR CONTRACTOR NEW CONCEPT DEV. CORP. PHONE: Business 6603 2590 Home

ADDRESS P.O. BOX 1335 TROUTMAN NC 28166

LOCATION NC 90 WEST, TL 2ND LACKEY FARM ROAD TR PLANK BARN ROAD, LOT AT END ON RIGHT

SUBDIVISION GORDON ACRE BLOCK / SECTION LOT 1 LOT AREA 0.77 ACRE SITE CLASS PS DESIGN FLOW 480 L.T.A.R. 0.356AD /FT²

Septic Tank: 1000 Gallons; STB 1012 Date 6/12/00
Pump Tank: Gallons; PT Date
Pump Make: Model Serial No.
Nitrification Field: No Fields 1 Square Feet 82 TO 1380 Linear Feet 345+
No Lines FOUR Trench Width 36" Max Trench Bottom Depth 36" Stone Depth SAND 6"

☑ New System ☐ Repair System Type: I, II, (III), IV, V, VI
System Description: 25% REDUCTION SYSTEM
Repair System Description: 25% REDUCTION PUMP
Maintenance Agreement Required: ☐ Yes ☑ No

☑ House/Mod. Home No. Bedrooms 4
☐ Mobile Home No. Bathrooms 2
☐ Business No. Employees
☐ Other

☐ Slab ☑ Crawl Space ☐ Basement w/plumbing ☐ Basement wo/plumbing


Water Supply: ☐ Individual ☑ Public ☐ Community

Comments:/Conditions: INSTALL 25% REDUCTION SYSTEM USING FIFTY-SEVEN (57) CHAMBERS ON CONTOUR AS FLAGGED AT REQUEST

SCALE: 1" = 50'

Comments:/Conditions:

INITIAL SITE SKETCH

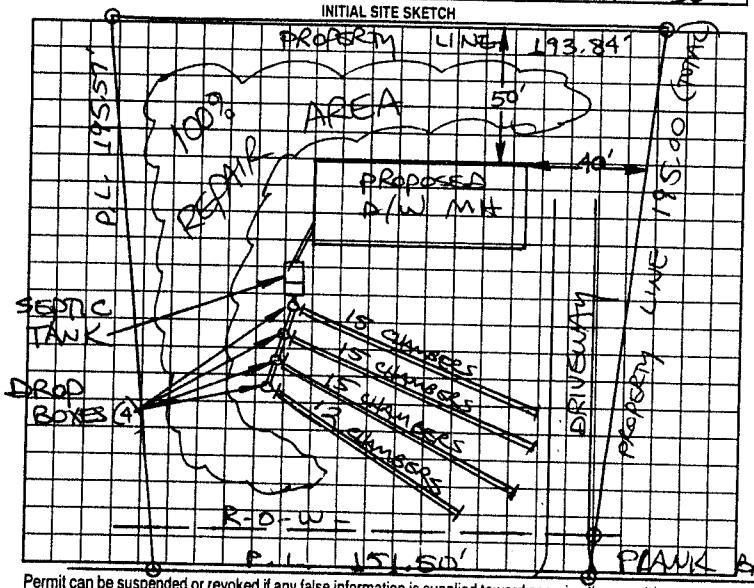

AS BUILT SKETCH

System Installed As Designed

Permit can be suspended or revoked if any false information is supplied toward securing the permit/any unauthorized changes are made to the site/any unauthorized changes are made in the installation of the system. Improvement Permit with plat valid without expiration. Improvement Permit with site plan valid for sixty months. Authorization to Construct is valid for a period equal to that of Improvement Permit - not to exceed sixty months.

Signed: [signature] date 6-19-2000 Installed by: CRAIG Thompson

Improvement Permit by: STEVE HEDRICK date 6-14-2000 Operation Permit by: [signature] date July 19 2000

Authorization to Construct by: STEVE HEDRICK date 6-14-2000 Existing System Inspection by: date

HEALTH DEPT. COPY: WHITE OWNER COPY (FINAL): YELLOW OWNER COPY (INITIAL): PINK