IREDELL COUNTY HEALTH DEPARTMENT

STATESVILLE 704-878-5305 CI MOORESVILLE 704-664-5281

IMPROVEMENT PERMIT / AUTHORIZATION TO CONSTRUCT / OPERATION PERMIT / EXISTING SYSTEM INSPECTION

PERMIT# 115396 PIN# 3797-52-4655 DATE 10/23/03

OWNER OR CONTRACTOR Lee Homes of Troutman PHONE: Business (704) 528-0848 Home —

ADDRESS 1036 Charlotte Hwy Troutman NC 28166

LOCATION Hwy 90 W @ WEST Lackey Farm Rd, @ Plank Barn Rd, @ End of Road (~500 ft off Road)

SUBDIVISION GORDON ACRES BLOCK / SECTION — LOT 3 LOT AREA 1.54 Ac SITE CLASS. PS DESIGN FLOW 360 L.T.A.R. .30 gpd/ft²

Septic Tank: 1000 Gallons; STB 1012 Date 6-18-03
Pump Tank: — Gallons; PT — Date —
Pump Make: — Model — Serial No. 0 with
Nitrification Field: No Fields 1 Square Feet 1200 Linear Feet —
No Lines 4 @ 100' Trench Width 36" Max Trench Bottom Depth 32" Gravel Depth 12"

☒ New System ☐ Repair System Type: I, (II), III, IV, V, VI
System Description: Gravity / Conventional /
Repair System Description: Pump, Grinder 25% Red.
Maintenance Agreement Required: ☐ Yes ☒ No


☐ House/Mod. Home No. Bedrooms 3
☒ Mobile Home No. Bathrooms 2
☐ Business No. Employees —
☐ Other —
☐ Slab ☒ Crawl Space ☐ Basement w/plumbing ☐ Basement wo/plumbing

Water Supply: ☐ Individual ☒ Public ☐ Community


Comments:/Conditions:
① Install lines on Contour
② Keep System 100' From wells

Comments:/Conditions:
Tuff-Tite Filter + ST Marker Installed
- Repair Area in same area as Initial Site Sketch

INITIAL SITE SKETCH

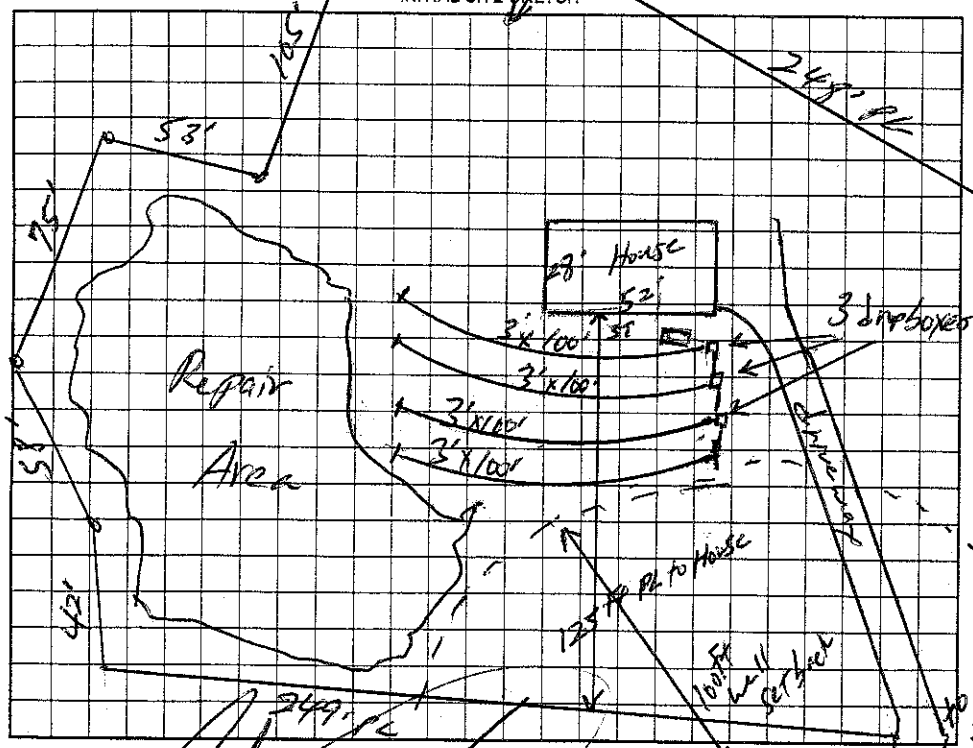

AS BUILT SKETCH

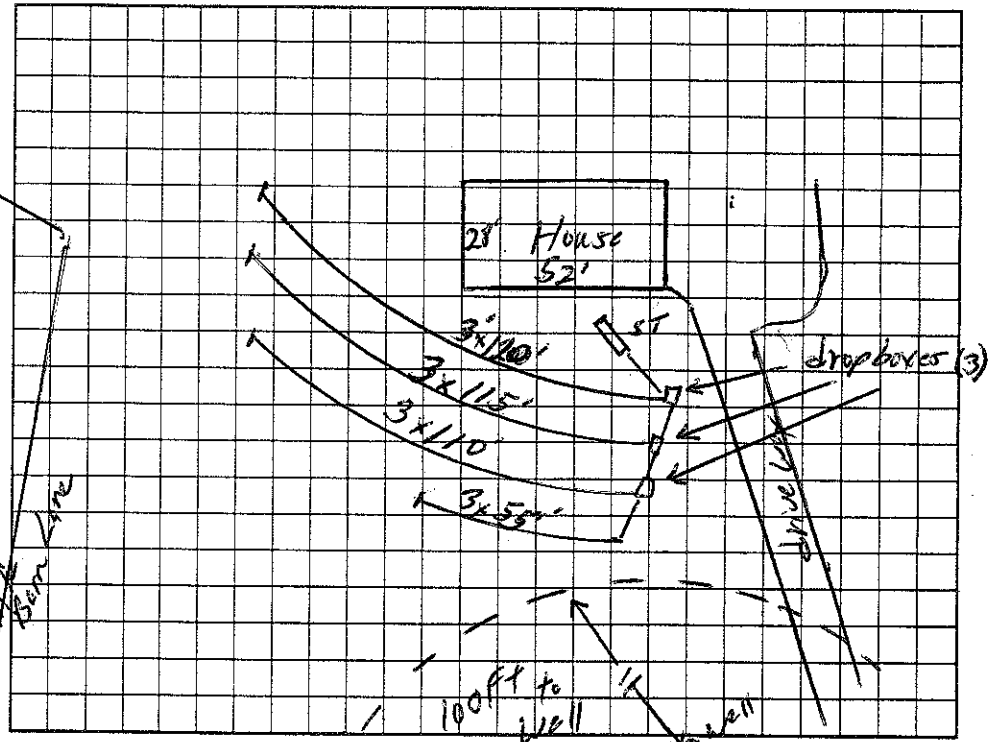

Permit can be suspended or revoked if any false information is supplied toward secure the permit/any unauthorized changes are made to the site/any unauthorized changes are made in the installation of the system. Improvement Permit with plat valid without expiration. Improvement Permit with site plan valid for sixty months. Authorization to Construct is valid for a period equal to that of Improvement Permit – not to exceed sixty months.

Signed: — date —

Improvement Permit by: William O. Johnson date 10/23/03

Authorization to Construct by: William O. Johnson date 10/23/03

Installed by: A-1 Backhoe

Operation Permit by: William O. Johnson date 12/2/03

Existing System Inspection by: — date —

HEALTH DEPT. COPY: WHITE OWNER COPY (FINAL): YELLOW OWNER COPY (INITIAL): PINK