# IREDELL COUNTY HEALTH DEPARTMENT

Authorization to construct

STATESVILLE 704-878-5305 MOORESVILLE 704-664-5281

## IMPROVEMENT PERMIT / ~~CERTIFICATE OF COMPLETION~~ / OPERATION PERMIT / EXISTING SYSTEM INSPECTION

PROPERTY DESCRIPTION NO. 25232 DATE 10-28-96 TAX MAP NO. 95-7A 24 Watershed: ☐ Yes ☒ No

OWNER OR CONTRACTOR Victoria Summers PHONE: Business Home 873-1532

ADDRESS 915 Wilmington Ave Statesville

LOCATION 64W (New Road) TR Lackey Farm Rd (2nd Road) TL Phoenix Barn Rd 2nd lot on Left

SUBDIVISION Stony Hill BLOCK / SECTION LOT 24 LOT AREA SITE CLASS. P/S DESIGN FLOW 360 L.T.A.R. 0.32

Septic Tank: 1000 Gallons; STB 1012 Date 2-26-97

Pump Tank: Gallons; PT Date

Pump Make: Model Serial No.

Nitrification Field: No Fields 1 Square Feet 1125 Linear Feet 375

No Lines 4 Trench Width 36in Max Trench Bottom Depth 36in Gravel Depth 12in

☒ New System ☐ Repair System Type: I, ☒ II, III, IV, V, VI

System Description: Gravity Conventional

Repair System Description: Gravity Conventional

Maintenance Agreement Required: ☐ Yes ☒ No

☒ House/Mod. Home ☐ Mobile Home ☐ Business ☐ Other

No. Bedrooms 3 No. Bathrooms 2 No. Employees


☐ Slab ☒ Crawl Space ☐ Basement w/plumbing ☐ Basement wo/plumbing

Water Supply: ☐ Individual ☐ Community ☒ Public


Comments: keep lines on center 9ft on center

Comments:

INITIAL SITE SKETCH 338

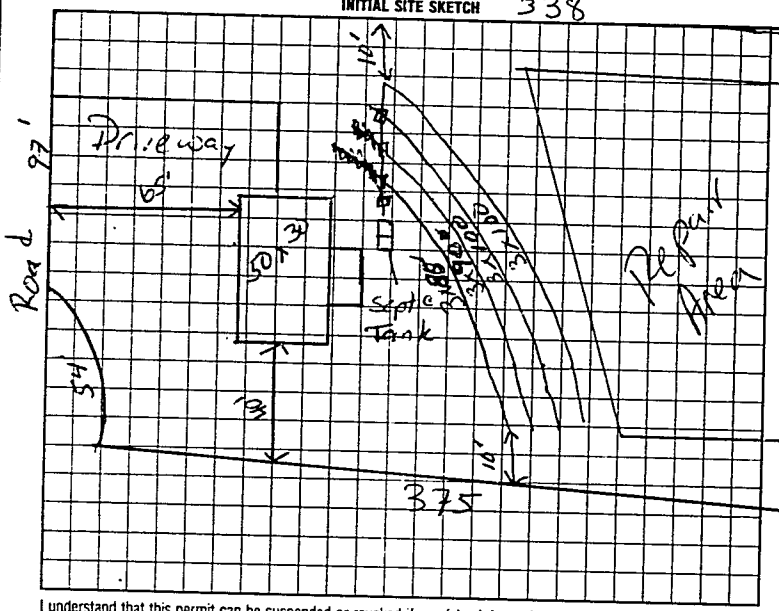


AS BUILT SKETCH

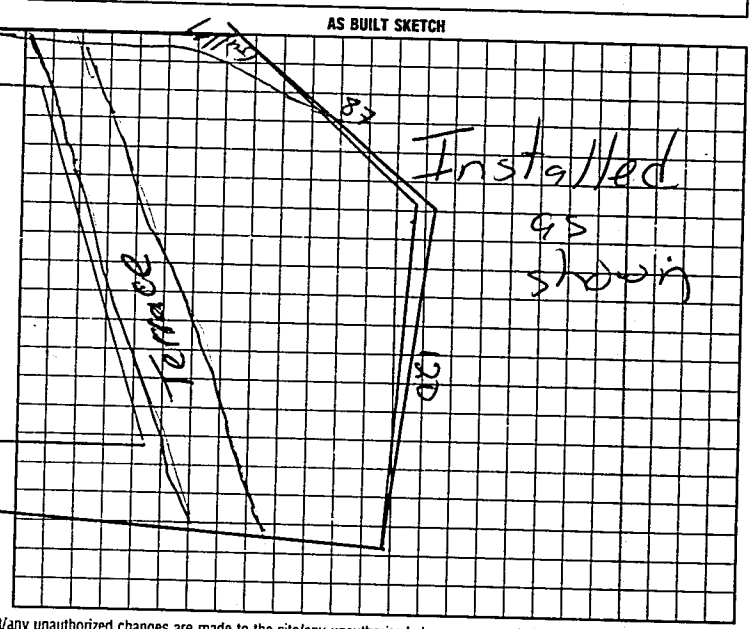


I understand that this permit can be suspended or revoked if any false information is supplied toward securing the permit/any unauthorized changes are made to the site/any unauthorized changes are made in the installation of the system.

Authorization to Const. expires 5 yrs after issue date

Signed: Victoria Summers

Improvement Permit by: Mark C Ort RS date 10-28-96

Existing System Inspection by: Authorization Const. Mark C Ort RS date 10-28-96

Installed by: Esker Elder

Certificate of Completion by: date

Operation Permit by: Mark C Ort RS date 5-1-97

HEALTH DEPT. COPY: WHITE INSPECTION COPY (FINAL): GREEN OWNER COPY (FINAL): YELLOW INSPECTION COPY (INITIAL): PINK OWNER COPY (INITIAL): GOLD