IREDELL COUNTY HEALTH DEPARTMENT

Statesville Office (704) 878-5305 Mooresville Office (704) 660-3625 PERMIT # 179188

IMPROVEMENT PERMIT / AUTHORIZATION TO CONSTRUCT / OPERATION PERMIT / EXISTING SYSTEM

PIN # 3797527811

APPLICANT: Stephanie Bumgarner APPLICANT ADDRESS: PO Box 605 Stony Point

SITE ADDRESS: 5249 Taylorsville Hwy PHONE: 704-380-4130 ALT. PHONE: N/A


SITE DIRECTIONS: Hwy 90 W Property on Left just past Lackey Farm Rd.

SUBDIVISION: N/A SECTION: N/A LOT # N/A LOT AREA: .72 acres DESIGN FLOW: 360 gpd L.T.A.R.: 0.3

Septic Tank	1000 (gal)	STB 1006-760	Date 9-15	☑ New System	☐ Repair	☐ Expansion	System Type: I II ☒ III IV V VI	☑ Residence	No. Bedrooms	3	Water Supply
Pump Tank	(gal)	PT	Date	System Description:	25% Reduction			☐ Business	No. Persons	6	☐ Private
Pump Make		Model	Serial #	Repair System Description:	Low Pressure PPBPS			☐ Other	No. Employees		☑ Public
# Nitrification Fields	1	# Lines 3	Linear Ft: 300	Maintenance Agreement Required:	☐ YES	☑ NO		☐ Slab	☑ Crawl Space		☐ Community
Trench Width	36"	Max. Trench Bottom Depth	36"	Gravel Depth	N/A	☑ GRAVITY	☐ PRESSURE	☐ Basement w/plumbing		☐ Basement w/o plumbing	

Comments / Conditions: Install a 25% Reduction system on contour with serial distribution. Grade area below nitrification field to achieve positive drainage away from nitrification field

INITIAL SITE SKETCH

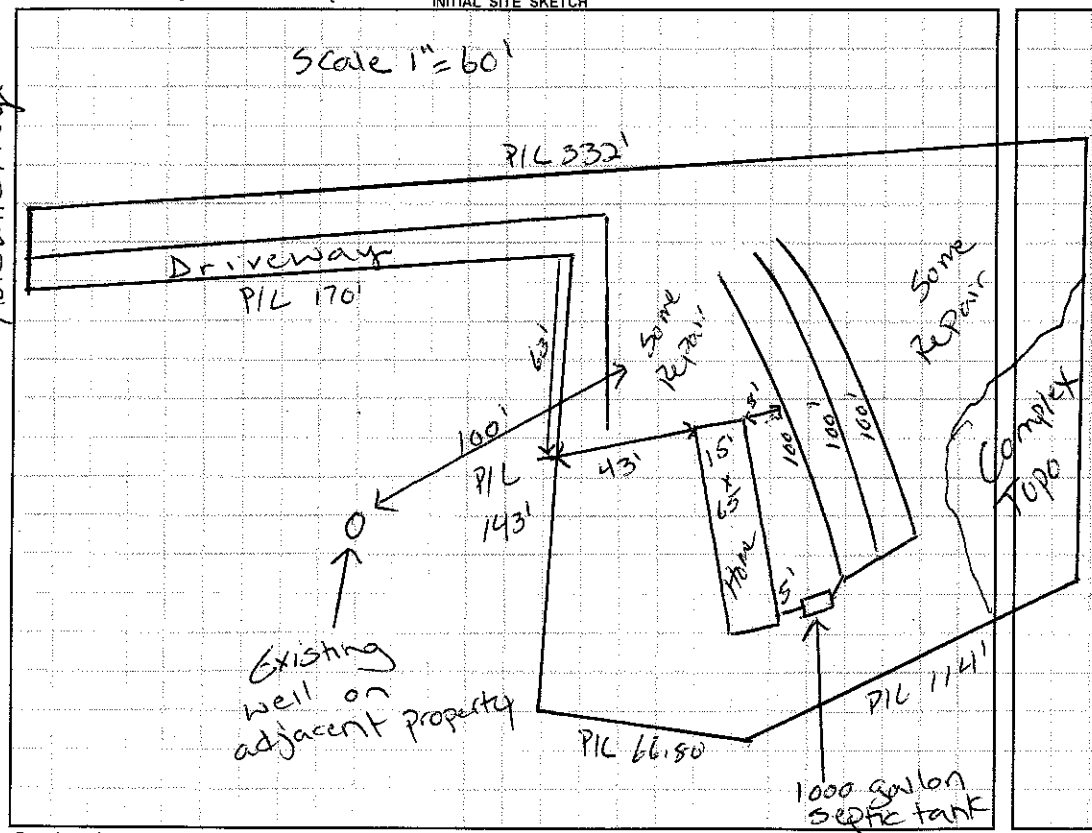

AS BUILT SKETCH

- Red Polylok filter installed
- Quick 4 Chambers installed
- House not set at time of inspection
- Installed as drawn

Permit can be suspended or revoked if any false information is supplied toward securing the permit / any unauthorized changes are made to the site / any unauthorized changes are made in the installation of the system. **CONTACT A LOCATOR SERVICE PRIOR TO ANY EXCAVATION**

☐ **IMPROVEMENT PERMIT** *with plat valid without expiration.* ☑ **IMPROVEMENT PERMIT** *with site plan valid for 60 mos.* ☑ **AUTHORIZATION TO CONSTRUCT** *valid for period equal to IMPROVEMENT PERMIT--not to exceed 60 mo.*

Owner / Applicant Signature: Stephanie Bumgarner Date: 1-27-14 Installed by: A1 Backhoe

IMPROVEMENT PERMIT by: Justin Henderson Date: 1-24-14 OPERATION PERMIT by: Justin Henderson Date: 2-20-14

AUTHORIZATION TO CONSTRUCT by: Justin Henderson Date: 1-24-14 Existing System Inspected by: Date:

Health Dept. Copy - WHITE Applicant (Final Approval) - YELLOW Applicant (Conditional Approval) - PINK