IREDELL COUNTY HEALTH DEPARTMENT

STATESVILLE 704-878-5305 MOORESVILLE 704-664-5281

IMPROVEMENT PERMIT / AUTHORIZATION TO CONSTRUCT / OPERATION PERMIT / EXISTING SYSTEM INSPECTION

PERMIT# 102790 PIN# 3797-52-8411 DATE 11/30/01

OWNER OR CONTRACTOR Stephanie J. Jones-Daniels PHONE: Business — Home (704) 585-2413

ADDRESS P.O. Box 44 Scotts N.C.

LOCATION Hwy 64 west (R) West Lacky Farm Road (L) Plonk Barn Rd. 2nd lot on the right

SUBDIVISION — BLOCK / SECTION — LOT 2 LOT AREA 1.33 Ac. SITE CLASS. PS DESIGN FLOW 480 L.T.A.R. .25 gpd/ft²

Septic Tank: 1000 Gallons; STB 825 Date 10-16-01
Pump Tank: — Gallons; PT — Date —
Pump Make: — Model — Serial No —
Nitrification Field: No Fields 1 Square Feet 1920 Linear Feet 480
No Lines — Trench Width 36" Max Trench Bottom Depth 30" Gravel Depth NA

[X] New System [ ] Repair System Type: I, II, [III], IV, V, VI
System Description: Gravity, 25% Reduction
Repair System Description: Pump, Conventional
Maintenance Agreement Required: [ ] Yes [X] No


[ ] House/Mod. Home No. Bedrooms 4
[X] Mobile Home No. Bathrooms 2
[ ] Business No. Employees —
[ ] Other —
[ ] Slab [X] Crawl Space [ ] Basement w/plumbing [ ] Basement wo/plumbing

Water Supply: [ ] Individual [X] Public [ ] Community


Comments:/Conditions: ① Maintain Proper Setbacks ② Do not install when wet ③ Install 25% Reduction System

Comments:/Conditions:
- Poly Lok Filter Installed
- 49' - 10" Section HDPE Cleanout Installed

INITIAL SITE SKETCH

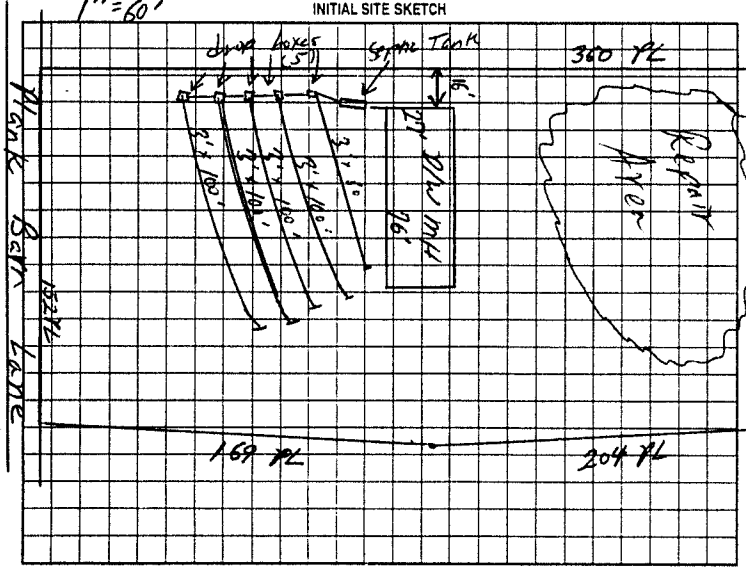

AS BUILT SKETCH

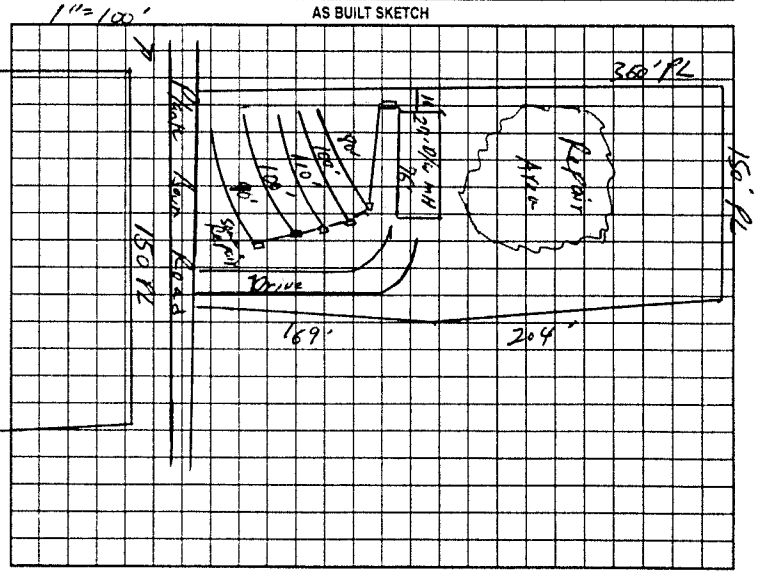

Permit can be suspended or revoked if any false information is supplied toward securing the permit/any unauthorized changes are made to the site/any unauthorized changes are made in the installation of the system. Improvement Permit with plat valid without expiration. Improvement Permit with site plan valid for sixty months. Authorization to Construct is valid for a period equal to that of Improvement Permit – not to exceed sixty months.

Signed: Michael D. Sanders date 10-4-01 Installed by: Bobs Back hoe

Improvement Permit by: William O. Johnson date 12/3/01 Operation Permit by: William O. Johnson date 12/13/01

Authorization to Construct by: William O. Johnson date 12/3/01 Existing System Inspection by: — date —

HEALTH DEPT COPY: WHITE OWNER COPY (FINAL): YELLOW OWNER COPY (INITIAL): PINK