IREDELL COUNTY HEALTH DEPARTMENT

STATESVILLE 704-878-5305 MOORESVILLE 704-664-5281

IMPROVEMENT PERMIT / CERTIFICATE OF COMPLETION / OPERATION PERMIT / EXISTING SYSTEM INSPE

PROPERTY DESCRIPTION NO. 069600 DATE 10.8.97 TAX MAP NO. 3797 52 9275 Watershed: ☐ Yes

OWNER OR CONTRACTOR ORTEGA TATUM PHONE: Business _____ Home 871-9996

ADDRESS 357 INGLEWOOD DRIVE, STATESVILLE, NC 28677

LOCATION NC 90 W, TL W. LACKEY FARM RD, TR PLANK BARN ROAD 1st LOT ON RIGHT

SUBDIVISION SUNNY HILLS BLOCK / SECTION _____ LOT 311 LOT AREA 1.0348 ACRE SITE CLASS. PS DESIGN FLOW 360 L.T.A.R. 0.25 GPD/FT²

Septic Tank: 1000 Gallons; STB _____ Date _____

Pump Tank: _____ Gallons; PT _____ Date _____

Pump Make: _____ Model _____ Serial No. _____

Nitrification Field: No Fields 1 Square Feet 1440 Linear Feet 480

No Lines SIX Trench Width 36 Max Trench Bottom Depth 30" Gravel Depth 12"

☑ New System ☐ Repair System Type: I, II, III, IV, V, VI

System Description: CONVENTIONAL GRAVITY

Repair System Description: CONV. GRAVITY

Maintenance Agreement Required: ☐ Yes ☑ No

☐ House/Mod. Home No. Bedrooms 3

☑ Mobile Home No. Bathrooms 2

☐ Business No. Employees _____

☐ Other _____


☐ Slab ☑ Crawl Space ☐ Basement w/plumbing ☐ Basement wo/plumbing

Water Supply: ☐ Individual ☐ Community ☑ Public

Comments: ① INSTALL SUBSURFACE INTERCEPT DRAINAGE DITCH AS SHOWN BEGINNING 42" DEEP W/ FALL OUT TO DAYLIGHT ② USE ONE FLOW DIVIDER TEE TO ACHIEVE EQUAL DISTRIBUTION INTO EACH OF TWO DIST. BOXES FEEDING THREE LINES EACH.

Comments:

P.L. 220.29 **INITIAL SITE SKETCH** SCALE: 1" = 50'

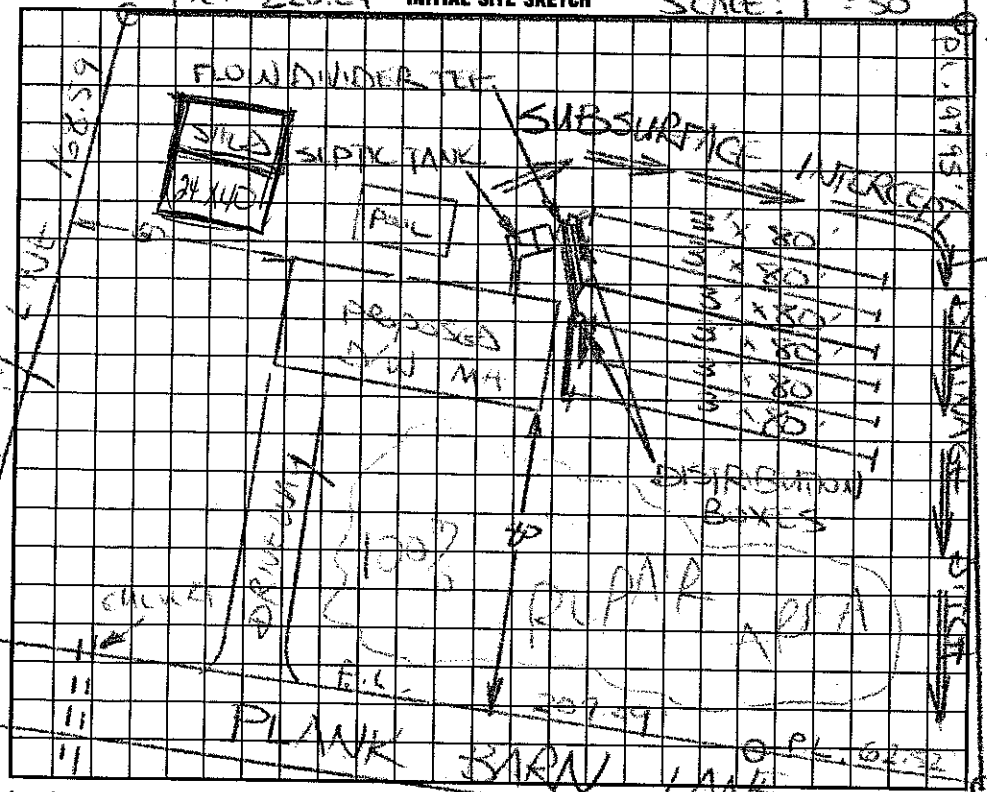

AS BUILT SKETCH

The proposed 24x40' Replacement Bldg addition does not appear to impact the existing septic system.

**NOTE: Septic Repair IS nearby near bldg.

R.S.

Date: 5-7-10

ICHD-Environmental Health Division

I understand that this permit can be suspended or revoked if any false information is supplied toward securing the permit/any unauthorized changes are made to the site/any unauthorized changes are made in the installation of the system. Improvement Permit is valid for 60 months from date of issuance. APPLICATION FOR CONSTRUCT IS VALID FOR 60 MONTHS FROM DATE OF ISSUANCE.

Signed: X

Improvement Permit by: STEVE HENDRICK date 10.8.97

Existing System Inspection by: STEVE HENDRICK date 10.8.97

Installed by: _____

~~Certificate of Completion by:~~ _____ date _____

Operation Permit by: _____ date _____

HEALTH DEPT. COPY: WHITE INSPECTION COPY (FINAL): GREEN OWNER COPY (FINAL): YELLOW INSPECTION COPY (INITIAL): PINK OWNER COPY (INITIAL): GOLD