IREDELL COUNTY HEALTH DEPARTMENT

STATESVILLE 704-878-5305 MOORESVILLE 704-664-5281

IMPROVEMENT PERMIT / AUTHORIZATION TO CONSTRUCT / OPERATION PERMIT / EXISTING SYSTEM INSPECTION

CI

PERMIT# 116981 PIN# 3799-53-8588 DATE 12/3/03

OWNER OR CONTRACTOR ~~Jeffrey K. Klein~~ Comfort Home Prop. PHONE: Business — Home (704) 278-1498

ADDRESS ~~7010 Foster Road Cleveland N.C. 27013~~ 590 Mocksville Hwy, Statesville 28625

LOCATION Hwy 90 West, (R) on Saylor Lane (before County Line) Lot on Right

SUBDIVISION Calhoun Estates BLOCK / SECTION — LOT 1 LOT AREA .55 Acres SITE CLASS. P8 DESIGN FLOW 360 L.T.A.R. .30 gpd/ft²

Septic Tank: 1000 Gallons; STB 736 Date 1-28-06

Pump Tank: — Gallons; PT — Date —

Pump Make: — Model — Serial No. —

Nitrification Field: No Fields 1 Square Feet ~~Equiv to~~ 1200 Linear Feet 300'

No Lines 5 Trench Width 36 Max Trench Bottom Depth 30" Gravel Depth NA

☒ New System ☐ Repair System Type: I, II, ⓘ III, IV, V, VI

System Description: Gravity 25% Reduction

Repair System Description: ~~Pump~~ 50% Reduction

Maintenance Agreement Required: ☐ Yes ☒ No

☐ House/Mod. Home ☒ Mobile Home ☐ Business ☐ Other

No. Bedrooms 3 No. Bathrooms 2 No. Employees —

☐ Slab ☒ Crawl Space ☐ Basement w/plumbing ☐ Basement wo/plumbing


Water Supply: ☐ Individual ☒ Public ☐ Community

Comments:/Conditions: ① Maintain proper setbacks ② Installer contact Health Dept before septic Installation

Comments:/Conditions: POLY LOK Filter + MARKER

736" IB APPROVED PITS


INITIAL SITE SKETCH

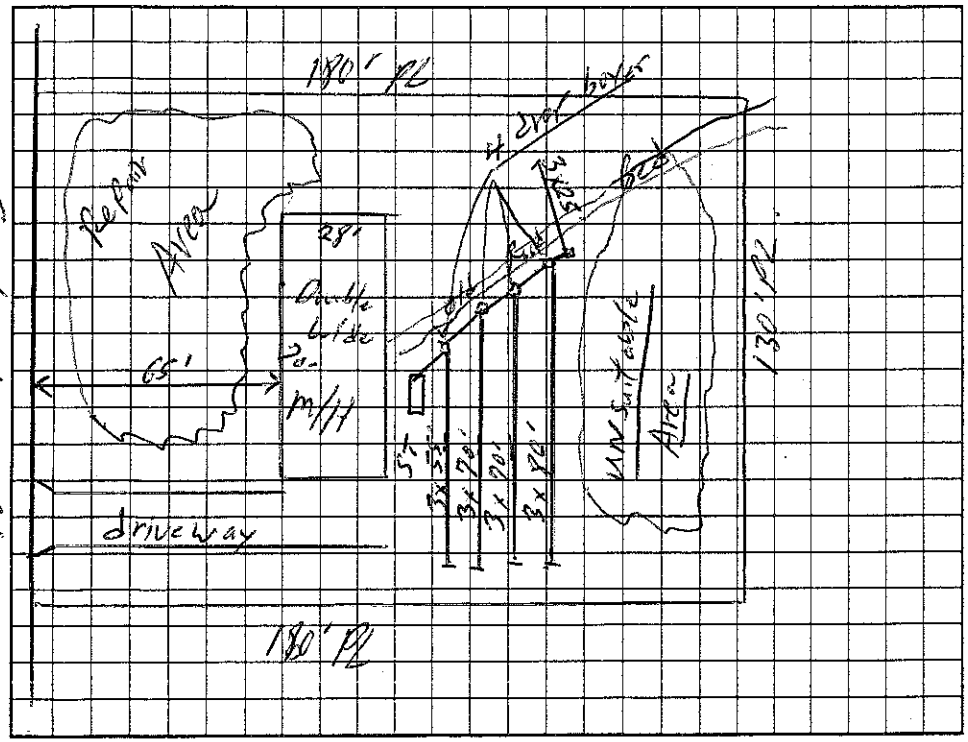

Saylor Lane R/W

AS BUILT SKETCH

Construction manager showed & verified septic is 10' + off P/L. He also authorized system changes. DUG PITS TO MAKE CHANGES & HAD TO CHANGE TO KEEP ON CONTOUR. SEE ATTACHED

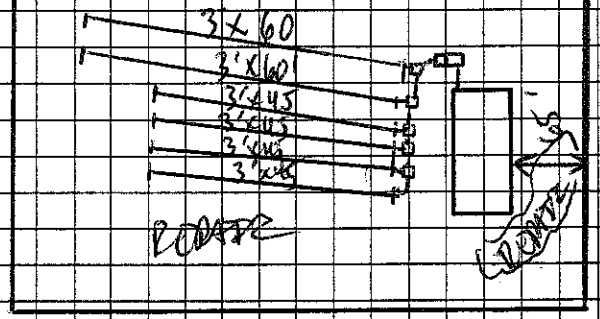

Permit can be suspended or revoked if any false information is supplied toward securing the permit/any unauthorized changes are made to the site/any unauthorized changes are made in the installation of the system. Improvement Permit with plat valid without expiration. Improvement Permit with site plan valid for sixty months. Authorization to Construct is valid for a period equal to that of Improvement Permit – not to exceed sixty months.

Signed: _____ date 10/3-03 Installed by: Propst Septic

Improvement Permit by: William O. Johnson date 12/3/03 Operation Permit by: _____ date 5-19-06

Authorization to Construct by: William O. Johnson date 12/3/03 Existing System Inspection by: _____ date _____

HEALTH DEPT. COPY: WHITE OWNER COPY (FINAL): YELLOW OWNER COPY (INITIAL): PINK