IREDELL COUNTY HEALTH DEPARTMENT

STATESVILLE 704-878-5305 MOORESVILLE 704-664-5281

IMPROVEMENT PERMIT / AUTHORIZATION TO CONSTRUCT / OPERATION PERMIT / EXISTING SYSTEM INSPECTION

PERMIT# 075416 PIN# 3797 53 9928 DATE 7-23-98

OWNER OR CONTRACTOR STEVE & LINDA ERVIN PHONE: Business 585-2728 Home

ADDRESS 245 DAGENHART FARM ROAD, STATESVILLE, NC 28677

LOCATION NC 90 WEST, TR CALHOUN ROAD, TR SAYLOR ROAD, 1ST LOT ON LEFT

SUBDIVISION CALHOUN EST. BLOCK / SECTION LOT 3 LOT AREA 0.513 ACRE SITE CLASS. RS DESIGN FLOW 360 L.T.A.R. 0.25 GPD/FT²

Septic Tank: 1000 Gallons; STB 1012 Date 7-21-98
Pump Tank: Gallons; PT Date
Pump Make: Model Serial No.
Nitrification Field: No Fields 1 Square Feet 1440 Linear Feet 480
No Lines SIX Trench Width 36" Max Trench Bottom Depth 36" Gravel Depth 12"

☑ New System ☐ Repair System Type: I, ☑ II, III, IV, V, VI
System Description: CONVENTIONAL, GRAVITY
Repair System Description: PPBPS PUMP-FED
Maintenance Agreement Required: ☐ Yes ☑ No

☐ House/Mod. Home ☑ Mobile Home ☐ Business ☐ Other
No. Bedrooms 3 No. Bathrooms 2 No. Employees


☐ Slab ☑ Crawl Space ☐ Basement w/plumbing ☐ Basement wo/plumbing

Water Supply: ☐ Individual ☑ Public ☐ Community

Comments:/Conditions: ① CONSTRUCT SURFACE DIVERSION DITCH AT LOCATION SHOWN ② USE ONE FLOW DIVIDER TEE TO ACHIEVE EQUAL DISTRIBUTION INTO TWO SETS OF DROP BOXES FEEDING THREE LINES PER SET.

Comments:/Conditions:

INITIAL SITE SKETCH

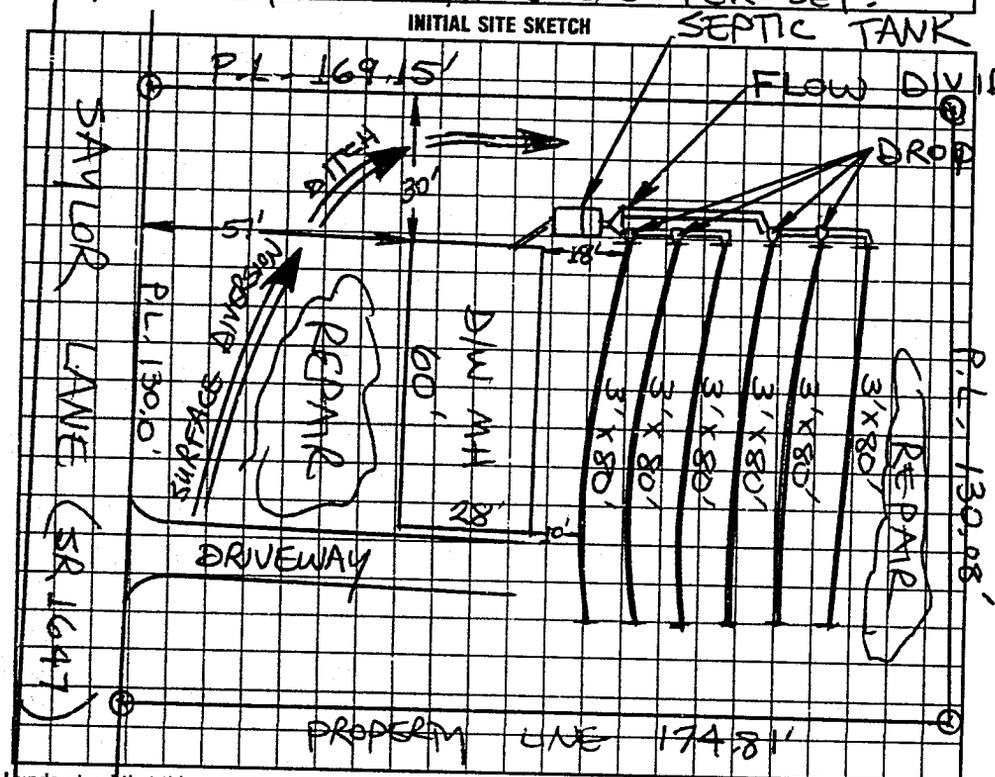

AS BUILT SKETCH

Installed as shown

I understand that this permit can be suspended or revoked if any false information is supplied toward securing the permit/any unauthorized changes are made to the site/any unauthorized changes are made in the installation of the system. Improvement Permit with plat valid without expiration. Improvement Permit with site plan valid for sixty months. Authorization to Construct is valid for a period equal to that of Improvement Permit – not to exceed sixty months.

Signed: [signature] date

Improvement Permit by: STEVE HEDRICK date 7-23-98

Authorization to Construct by: STEVE HEDRICK date 7-23-98

Installed by: Kenny Madison

Operation Permit by: [signature] date 9-25-98

Existing System Inspection by date

HEALTH DEPT COPY: WHITE INSPECTION COPY (FINAL): GREEN OWNER COPY (FINAL): YELLOW INSPECTION COPY (INITIAL): PINK OWNER COPY (INITIAL): GOLD