IREDELL COUNTY HEALTH DEPARTMENT

STATESVILLE 704-878-5305 MOORESVILLE 704-664-5281

IMPROVEMENT PERMIT / AUTHORIZATION TO CONSTRUCT / OPERATION PERMIT / EXISTING SYSTEM INSPECTION

PERMIT# 075415 PIN# 3797 53 9928 DATE 7-23-98

OWNER OR CONTRACTOR STEVEN & LINDA ERVIN PHONE: Business 585-2728 Home

ADDRESS 245 DAGENHART ROAD, STATESVILLE, NC 28677

LOCATION NC 90 WEST, TR CALHOUN ROAD, 1ST LOT ON RIGHT PAST SAYLOR LANE

SUBDIVISION CALHOUN EST. BLOCK / SECTION LOT 4 LOT AREA 0.702 ACRES SITE CLASS. PS DESIGN FLOW 360 L.T.A.R. 0.25 GPD/FT²

Septic Tank: 1000 Gallons; STB 1012 Date 7-21-98
Pump Tank: Gallons; PT Date
Pump Make: Model Serial No.
Nitrification Field: No Fields 1 Square Feet 1440 Linear Feet 480
No Lines FOUR Trench Width 36" Max Trench Bottom Depth 36" Gravel Depth 12"

☑ New System ☐ Repair System Type: I (II) III, IV, V, VI
System Description: CONVENTIONAL GRAVITY
Repair System Description: CONV. GRAV./pump
Maintenance Agreement Required: ☐ Yes ☑ No

☐ House/Mod. Home No. Bedrooms 3
☑ Mobile Home No. Bathrooms 2
☐ Business No. Employees
☐ Other


☐ Slab ☑ Crawl Space ☐ Basement w/plumbing ☐ Basement wo/plumbing

Water Supply: ☐ Individual ☑ Public ☐ Community


Comments:/Conditions:

Comments:/Conditions:

INITIAL SITE SKETCH SCALE: 1" = 40'

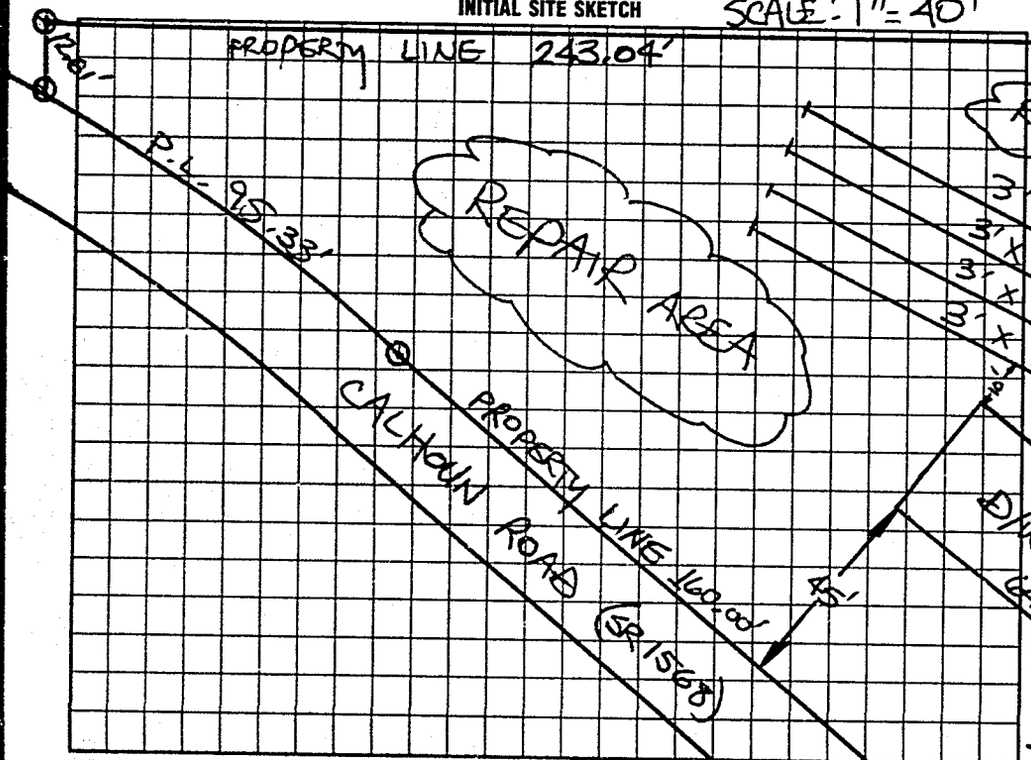

AS BUILT SKETCH

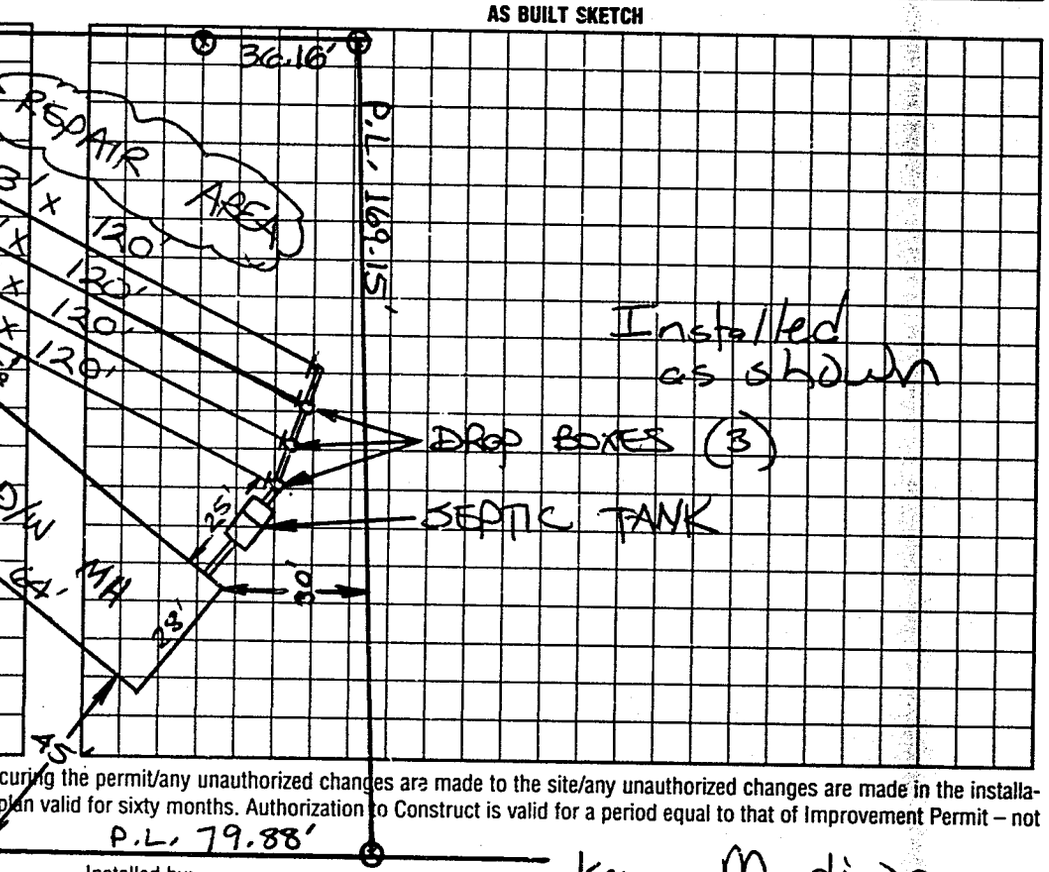

I understand that this permit can be suspended or revoked if any false information is supplied toward securing the permit/any unauthorized changes are made to the site/any unauthorized changes are made in the installation of the system. Improvement Permit with plat valid without expiration. Improvement Permit with site plan valid for sixty months. Authorization to Construct is valid for a period equal to that of Improvement Permit – not to exceed sixty months.

Signed: Ben Stikeleather date

Improvement Permit by: STEVE HEDRICK date 7-23-98

Authorization to Construct by: STEVE HEDRICK date 7-23-98

Installed by: Kenny Madison

Operation Permit by: SAYLOR LANE (SR1647) date 9-25-98

Existing System Inspection by: date

HEALTH DEPT. COPY: WHITE INSPECTION COPY (FINAL): GREEN OWNER COPY (FINAL): YELLOW INSPECTION COPY (INITIAL): PINK OWNER COPY (INITIAL): GOLD