IREDELL COUNTY HEALTH DEPARTMENT

Statesville Office (704) 878-5305 Mooresville Office (704) 660-3625 PERMIT # 20215b

IMPROVEMENT PERMIT / AUTHORIZATION TO CONSTRUCT / OPERATION PERMIT / EXISTING SYSTEM

PIN # 3797623229

APPLICANT: EMC Engineering Service APPLICANT ADDRESS: 1944 US Hwy 195 Suite A Leesburg GA

SITE ADDRESS: 5155 Taylorsville Hwy. PHONE: ALT. PHONE:

SITE DIRECTIONS: Hwy 64W TR Taylorsville Hwy Property on left at corner of W. Lackey Farm & Taylorsville Hwy

SUBDIVISION: N/A SECTION: N/A LOT # N/A LOT AREA: DESIGN FLOW: 200gpd L.T.A.R.: 0.3

Septic Tank 1530 min. (gal) STB 633-2000 Date 10-20-05
Pump Tank (gal) PT Date
Pump Make Model Serial #
Nitrification Fields 1 # Lines 3 Linear Ft: 168
Trench Width 36" Max. Trench Bottom Depth 36" Gravel Depth N/A


☑ New System ☐ Repair ☐ Expansion System Type: I II III IV V VI
System Description: 25% Reduction
Repair System Description: 25% Reduction
Maintenance Agreement Required: ☐ YES ☑ NO
☑ GRAVITY ☐ PRESSURE

☐ Residence ☑ Business ☐ Other ☑ Slab ☐ Basement w/plumbing
No. Bedrooms No. Persons No. Employees ☐ Crawl Space ☐ Basement w/o plumbing


Water Supply: ☐ Private ☑ Public ☐ Community

Comments / Conditions: IMPROVEMENTS ONLY! Combine 4 record Lots prior to issuance of CA. Install a 25% Reduction system on contour with serial distribution. Remove existing concrete foundation from sewage & repair area. - This permit is for a Dollar General Store with less than 8000 square feet retail space only! ☆ ☆Minimum Septic tank capacity is 1530 gallons ☆

INITIAL SITE SKETCH

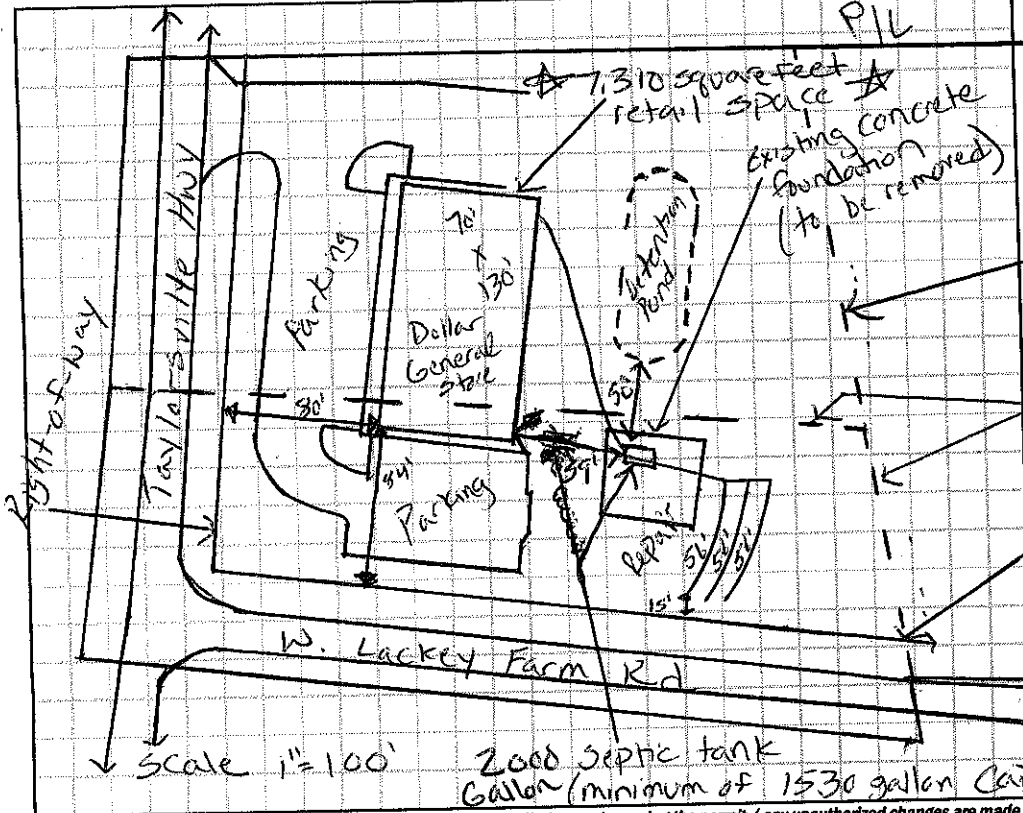

AS BUILT SKETCH

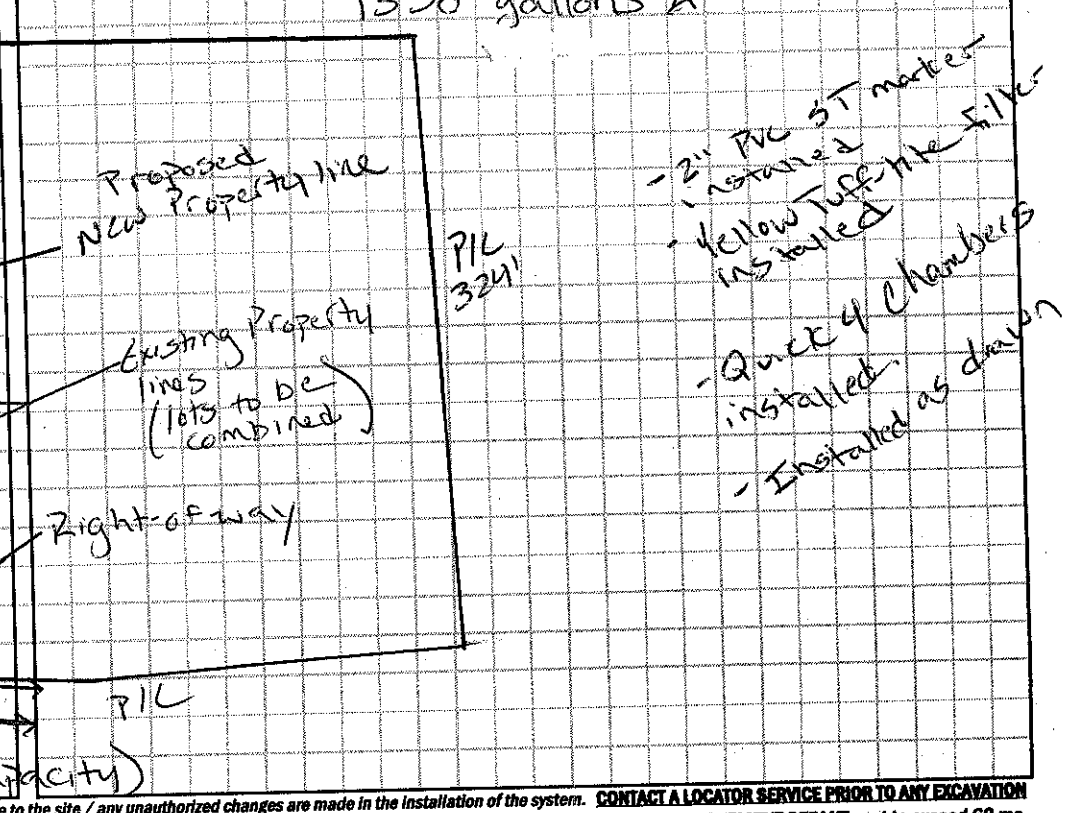

Permit can be suspended or revoked if any false information is supplied toward securing the permit / any unauthorized changes are made to the site / any unauthorized changes are made in the installation of the system. **CONTACT A LOCATOR SERVICE PRIOR TO ANY EXCAVATION**

☐ **IMPROVEMENT PERMIT** *with plat valid without expiration.* ☑ **IMPROVEMENT PERMIT** *with site plan valid for 60 mos.* ☑ **AUTHORIZATION TO CONSTRUCT** *valid for period equal to IMPROVEMENT PERMIT--not to exceed 60 mo.*

Owner / Applicant Signature: Date:
IMPROVEMENT PERMIT by: Justin Henderson Date: 5-19-14
AUTHORIZATION TO CONSTRUCT by: Justin Henderson Date: 10-2-14

Installed by: Steve Jordan
OPERATION PERMIT by: Justin Henderson Date: 1-22-15
Existing System Inspected by: Date:

Health Dept. Copy - WHITE Applicant (Final Approval) - YELLOW Applicant (Conditional Approval) - PINK