IREDELL COUNTY HEALTH DEPARTMENT

STATESVILLE 704-878-5305 MOORESVILLE 704-664-5281

IMPROVEMENT PERMIT / AUTHORIZATION TO CONSTRUCT / OPERATION PERMIT / EXISTING SYSTEM INSPECTION

PERMIT# 145796 PIN# 3797-62-5944 DATE 19 November-07

OWNER OR APPLICANT Nelson Re Hunger Building PHONE: Business 704-902-10429 Home

ADDRESS 304 Bowles Farm Rd. Statesville N.C.

LOCATION Hallyburton Rd. From Midway - on Left Across From Dessie Lane

SUBDIVISION BLOCK / SECTION LOT LOT AREA 3.155Ac. SITE CLASS PS DESIGN FLOW 300gld L.T.A.R. 0.3/1ft²/dy

Septic Tank: 1000g Gallons; STB 1000 Date 6-16-08

Pump Tank: Gallons; PT Date

Pump Make: Model Serial No.

Nitrification Field: No Fields 1 Square Feet ≥ 1000 Linear Feet 250'

No Lines 2 Trench Width 36" Max Trench Bottom Depth 36" Gravel Depth ☑ Gravity ☐ Pressure

☑ New System ☐ Repair ☐ Expansion System Type: I II III IV V VI

System Description: 25% Reduction

Repair System Description: 25% Reduction

Maintenance Agreement Required: ☐ Yes ☑ No

☐ House/Mod. Home ☐ Mobile Home ☑ Business ☐ Other

No. Bedrooms No. Persons No. Employees 12

Water Supply: ☐ Individual ☑ Public ☐ Community

☑ Slab ☐ Crawl Space ☐ Basement w/plumbing ☐ Basement wo/plumbing

Comments:/Conditions:


Follow contour
Mower setbacks

Comments:/Conditions: Bowles Fk Installed - ST has marker

INITIAL SITE SKETCH

Please See Attached Layout

AS BUILT SKETCH Y not Scale

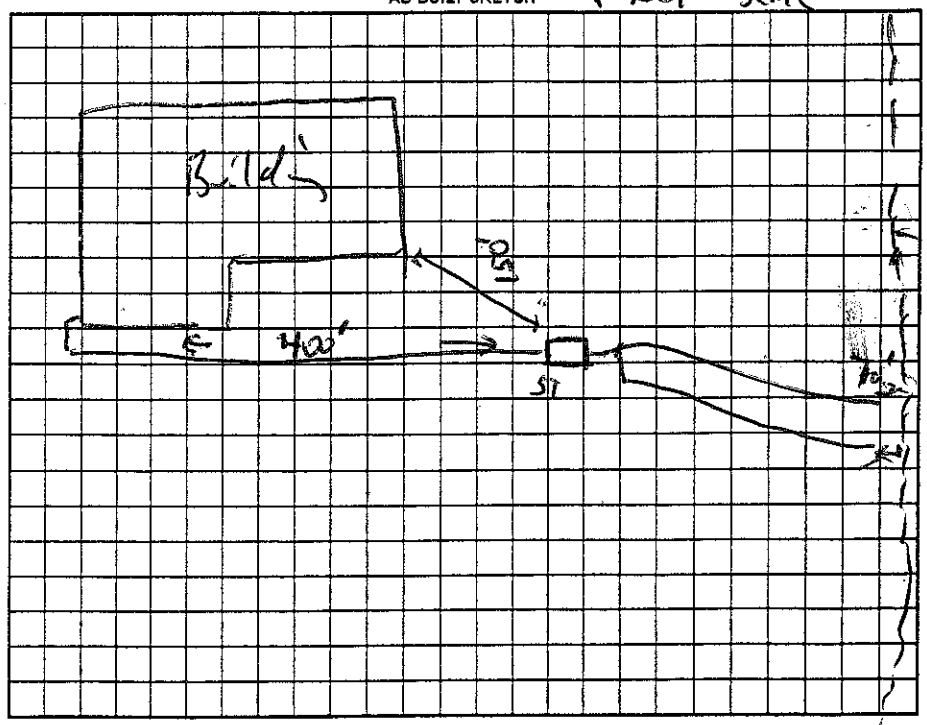


Permit can be suspended or revoked if any false information is supplied toward securing the permit/any unauthorized changes are made to the site/any unauthorized changes are made in the installation of the system. Improvement Permit with plat valid without expiration ☐ Improvement Permit with site plan valid for sixty months ☑ Authorization to Construct is valid for a period equal to that of Improvement Permit – not to exceed sixty months.

Signed: date 11-27-07 Installed by: Joey Cothren

Improvement Permit by: R.S. date 19 Nov. 07 Operation Permit by: R.S. date 19 Nov. 07

Authorization to Construct by: R.S. date 19 Nov. 07 Existing System Inspection by: date

HEALTH DEPT. COPY: WHITE OWNER COPY (FINAL): YELLOW OWNER COPY (INITIAL): PINK

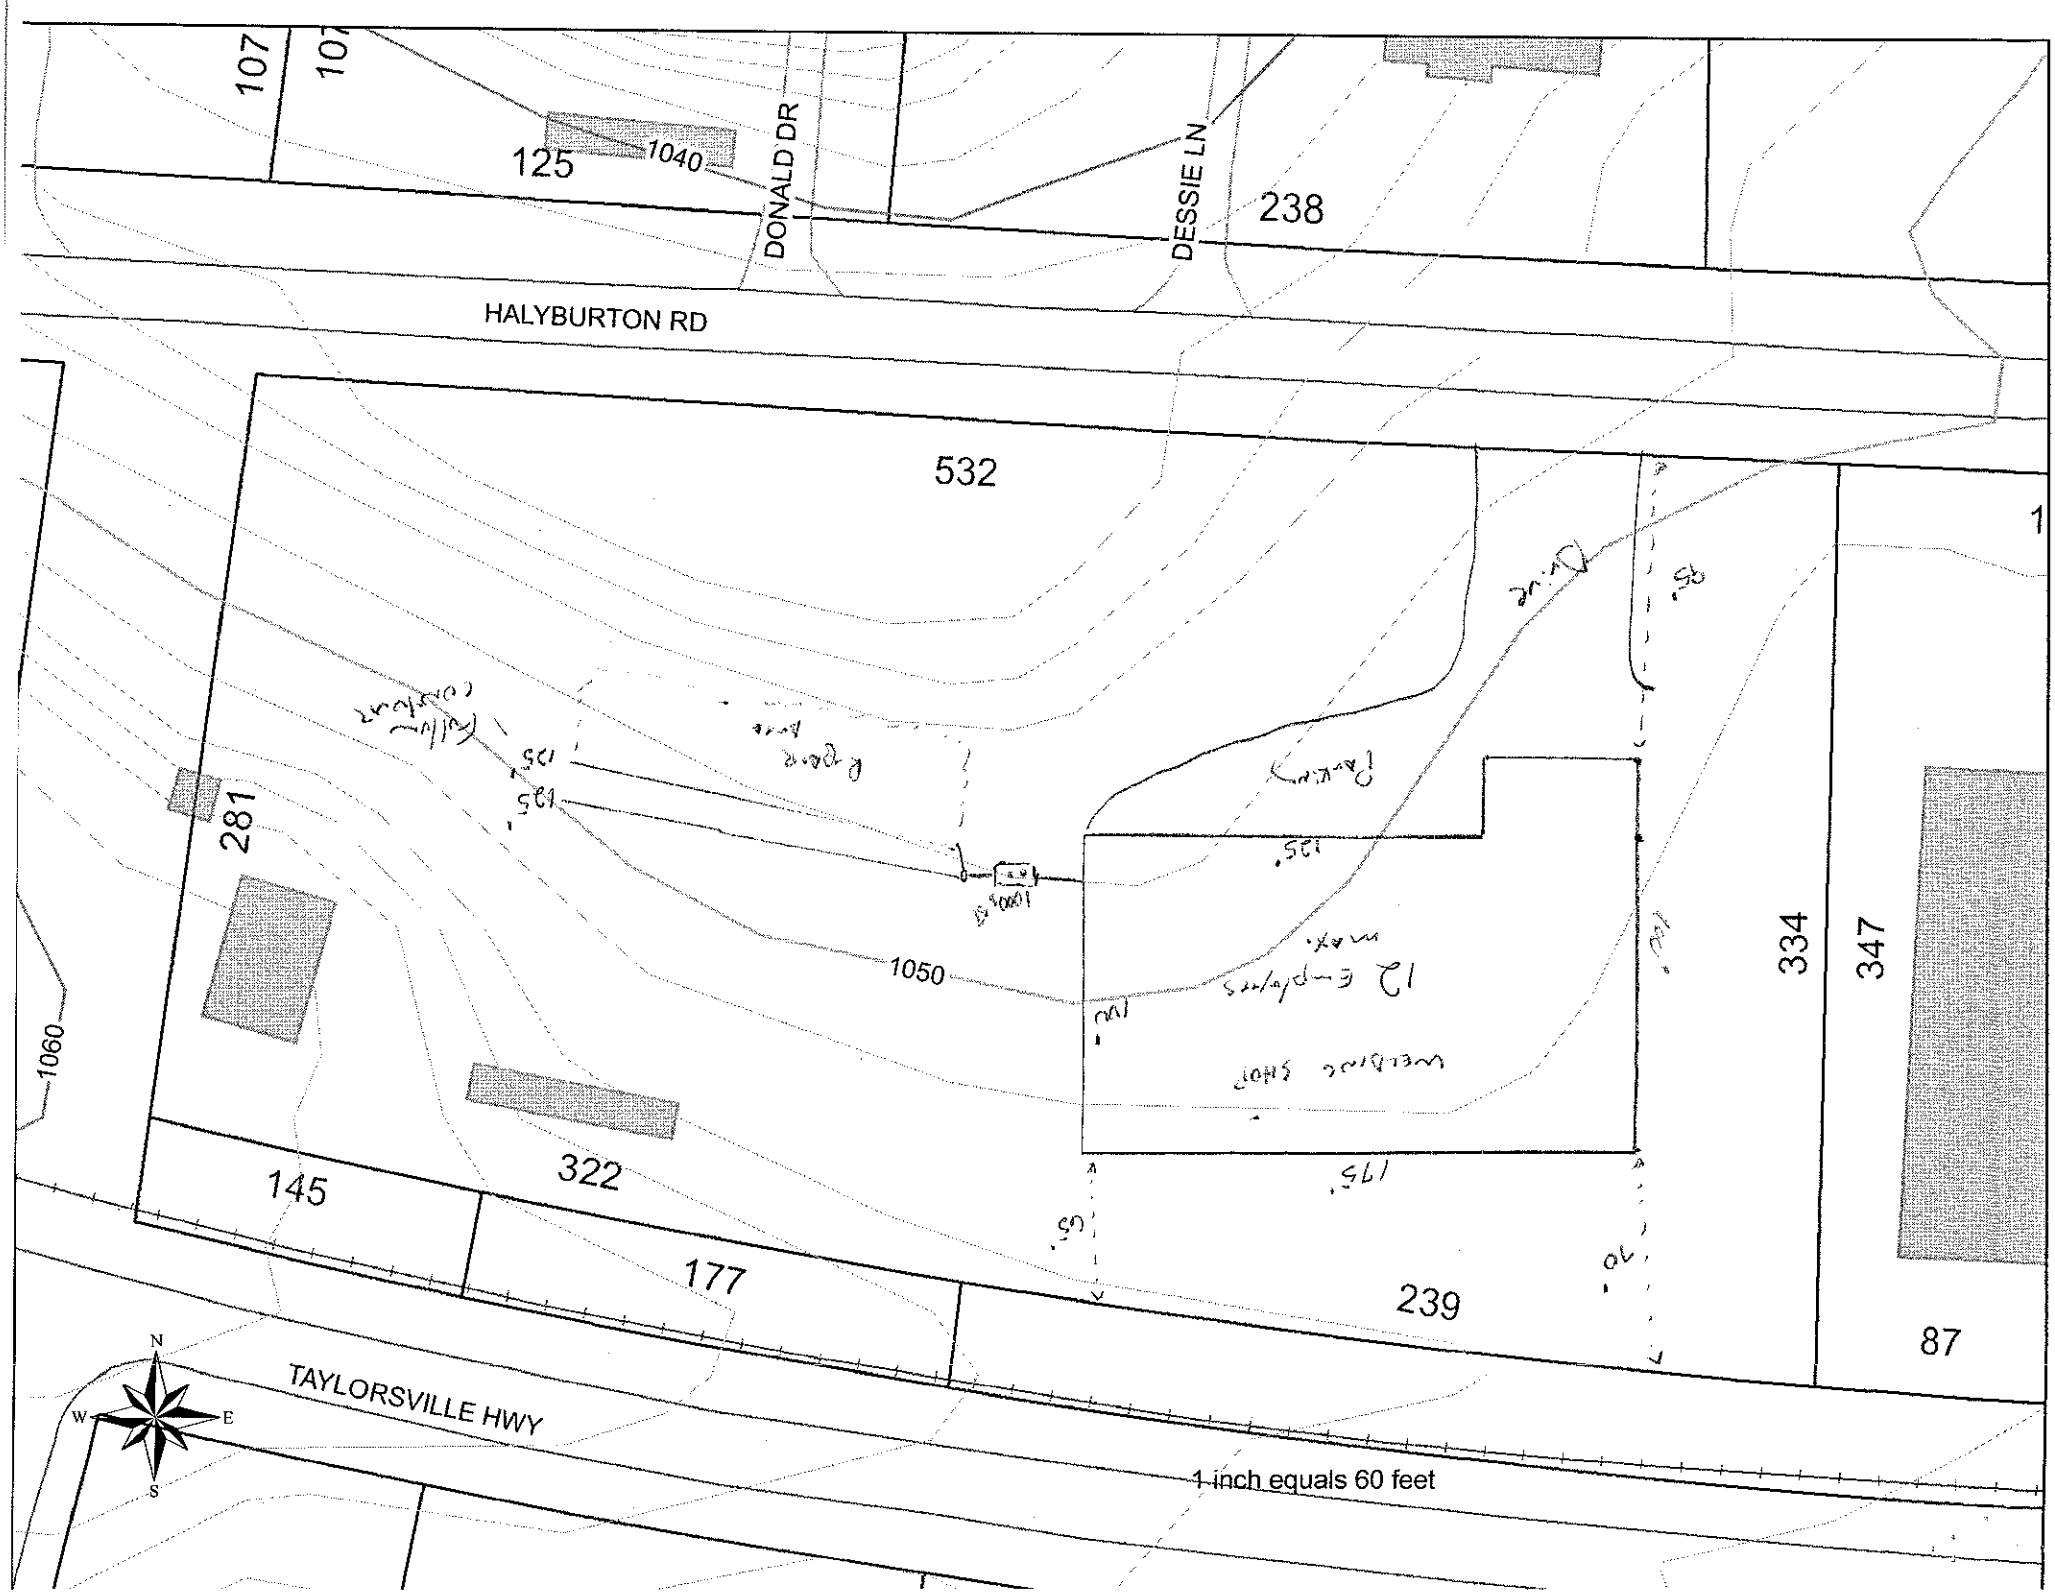
107
125
1040
DONALD DR
DESSIE LN
238
HALYBURTON RD
532
281
1050
1060
334
347
322
145
177
239
87
TAYLORSVILLE HWY
N
W
E
S
1 inch equals 60 feet