IREDELL COUNTY HEALTH DEPARTMENT

STATESVILLE 704-878-5305 MOORESVILLE 704-664-5281

IMPROVEMENT PERMIT / AUTHORIZATION TO CONSTRUCT / OPERATION PERMIT / EXISTING SYSTEM INSPECTION

PERMIT# _____ PIN# _____

OWNER OR CONTRACTOR TERRY CHURCH PHONE: Business _____ DATE 10-28-98

ADDRESS 248 HALYBURTON ROAD, STONY POINT, NC 28678 Home 585-9298

LOCATION NC 90W, TR MIDWAY ROAD, TL HALYBURTON ROAD ON RIGHT AT BOX #258

SUBDIVISION _____ BLOCK / SECTION _____ LOT _____ LOT AREA LIMITED SITE CLASS. P3 DESIGN FLOW 360 L.T.A.R. 0.30 GPD/FT²

Septic Tank: 1000 Gallons; STB 1012 Date 9-12-98

Pump Tank: _____ Gallons; PT _____ Date _____

Pump Make: _____ Model _____ Serial No. _____

Nitrification Field: No Fields 1 Square Feet 1200 Linear Feet 400

No Lines FOUR Trench Width 36" Max Trench Bottom Depth 36" Gravel Depth 12"

☑ New System ☐ Repair System Type: I, II, III, IV, V, VI

System Description: CONVENTIONAL GRAVITY

Repair System Description: MAX. FEASIBLE

Maintenance Agreement Required: ☐ Yes ☑ No

☑ House/Mod. Home No. Bedrooms 1

☐ Mobile Home No. Bathrooms 1

☐ Business No. Employees _____

☐ Other _____


☐ Slab ☑ Crawl Space ☐ Basement w/plumbing ☐ Basement wo/plumbing

Water Supply: ☐ Individual ☑ Public ☐ Community


Comments:/Conditions: ① LOCATE POWER & PHONE LINES UNDERGROUND PRIOR TO INSTALLATION ② ABANDON EXISTING SEPTIC TANK

Comments:/Conditions: SYSTEM INSTALLED DEEP & AS SHOWN DUE TO FILL MATERIAL ABOVE LINES

INITIAL SITE SKETCH SCALE: 1"=40'

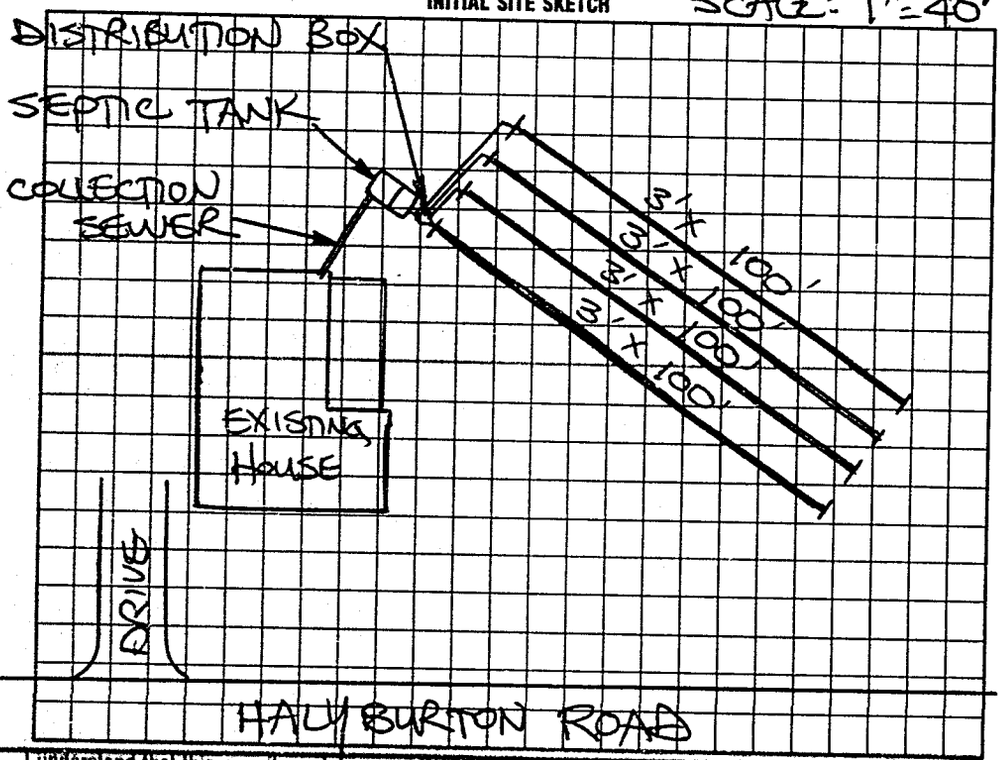

AS BUILT SKETCH

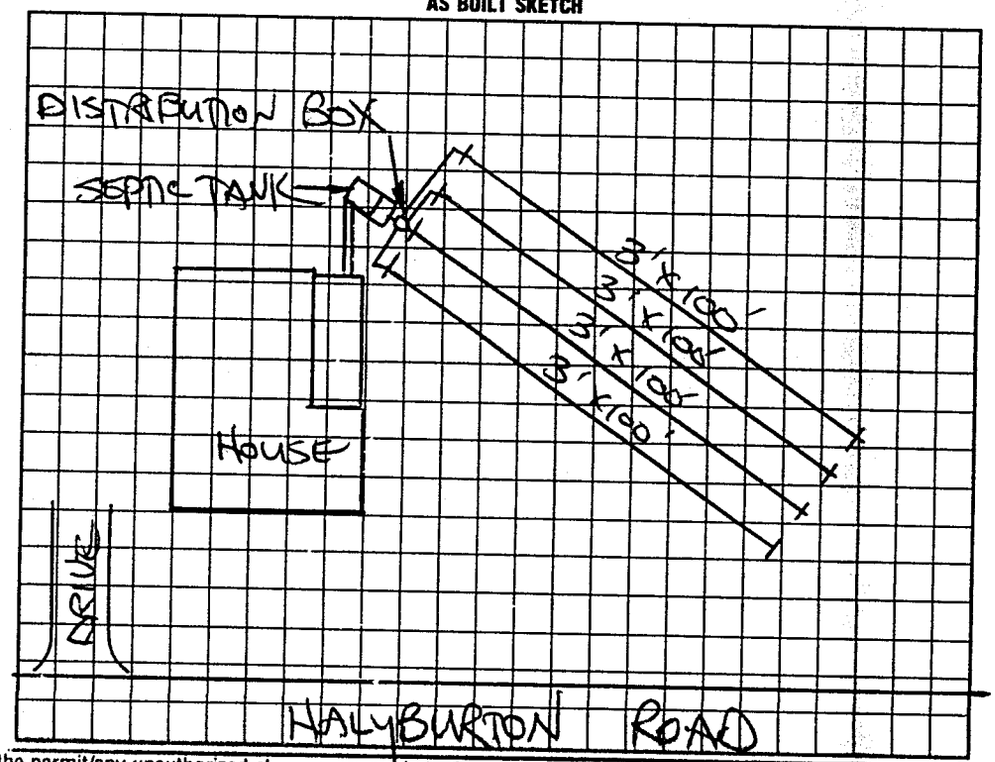

I understand that this permit can be suspended or revoked if any false information is supplied toward securing the permit/any unauthorized changes are made to the site/any unauthorized changes are made in the installation of the system. Improvement Permit with plat valid without expiration. Improvement Permit with site plan valid for sixty months. Authorization to Construct is valid for a period equal to that of Improvement Permit – not to exceed sixty months.

Signed: Donnie Lackey date 10-28-98

Improvement Permit by: STEVE HEDRICK date 10-28-98

Authorization to Construct by: STEVE HEDRICK date 10-28-98

Installed by: TOMMY COTTREN

Operation Permit by: STEVE HEDRICK date 11-12-98

Existing System Inspection by: _____ date _____

HEALTH DEPT. COPY: WHITE INSPECTION COPY (FINAL): GREEN OWNER COPY (FINAL): YELLOW INSPECTION COPY (INITIAL): PINK OWNER COPY (INITIAL): GOLD