IREDELL COUNTY HEALTH DEPARTMENT

Statesville Office (704) 878-5305 Mooresville Office (704) 660-3625 PERMIT # 214771

IMPROVEMENT PERMIT / AUTHORIZATION TO CONSTRUCT / OPERATION PERMIT / EXISTING SYSTEM

PIN # 3797633640.133

APPLICANT: Michael MacFadyen APPLICANT ADDRESS: 133 Donald Dr.

SITE ADDRESS: 133 Donald Dr. PHONE: 828-404-5398 ALT. PHONE: N/A

SITE DIRECTIONS: Taylorsville Hwy West TR Calhoun TR Halyburton TL Donald Drive Property on Left


SUBDIVISION: LACKEY MH Park SECTION: N/A LOT # N/A LOT AREA: 8.86 acres DESIGN FLOW: 240gpd L.T.A.R.: Existing

Septic Tank	Existing (gal)	STB	Date	☐ New System ☐ Repair ☐ Expansion System Type: I (II) III IV V VI	☑ Residence	No. Bedrooms	2
Pump Tank	(gal)	PT	Date	System Description: Existing	☐ Business	No. Persons	4
Pump Make	Model		Serial #	Repair System Description:	☐ Other	No. Employees	
# Nitrification Fields	Ex # Lines Ex		Linear Ft: Ex	Maintenance Agreement Required: ☐ YES ☑ NO	☐ Slab	☑ Crawl Space	Water Supply: ☐ Private ☑ Public ☐ Community
Trench Width	Ex Max. Trench Bottom Depth Ex		Gravel Depth Ex	☐ GRAVITY ☐ PRESSURE	☐ Basement w/plumbing	☐ Basement w/o plumbing	


Comments / Conditions:

- Maintain a minimum of 5' between home foundation and all components of septic tank system.

INITIAL SITE SKETCH

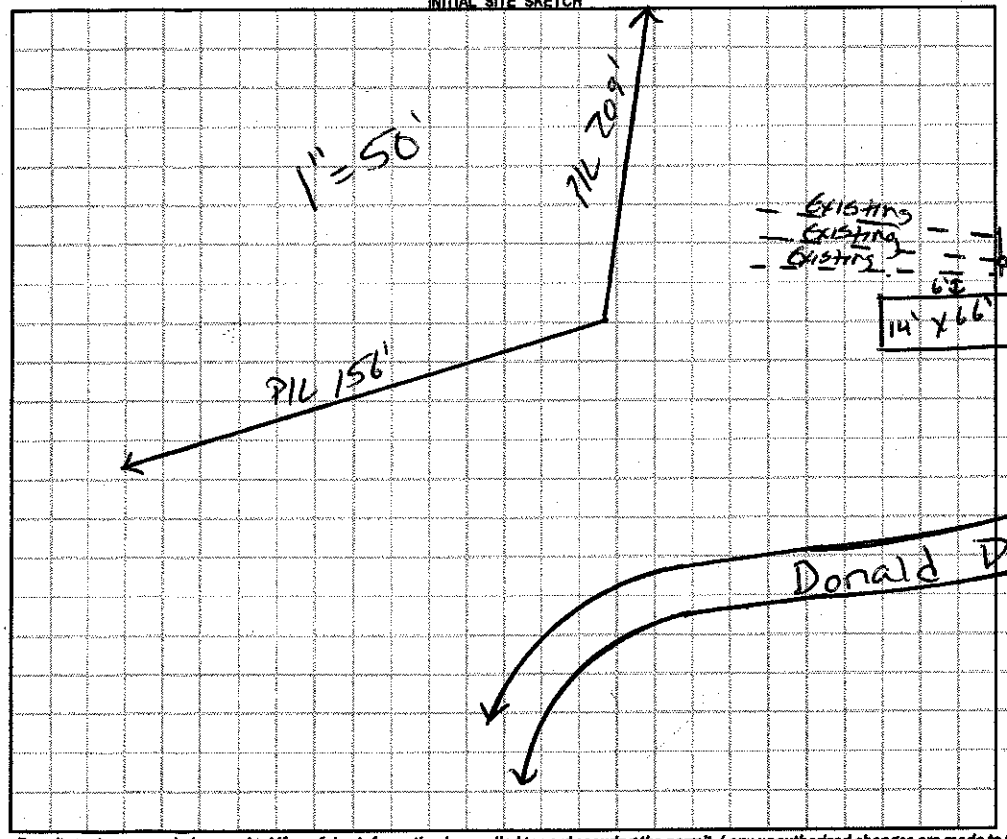

AS BUILT SKETCH

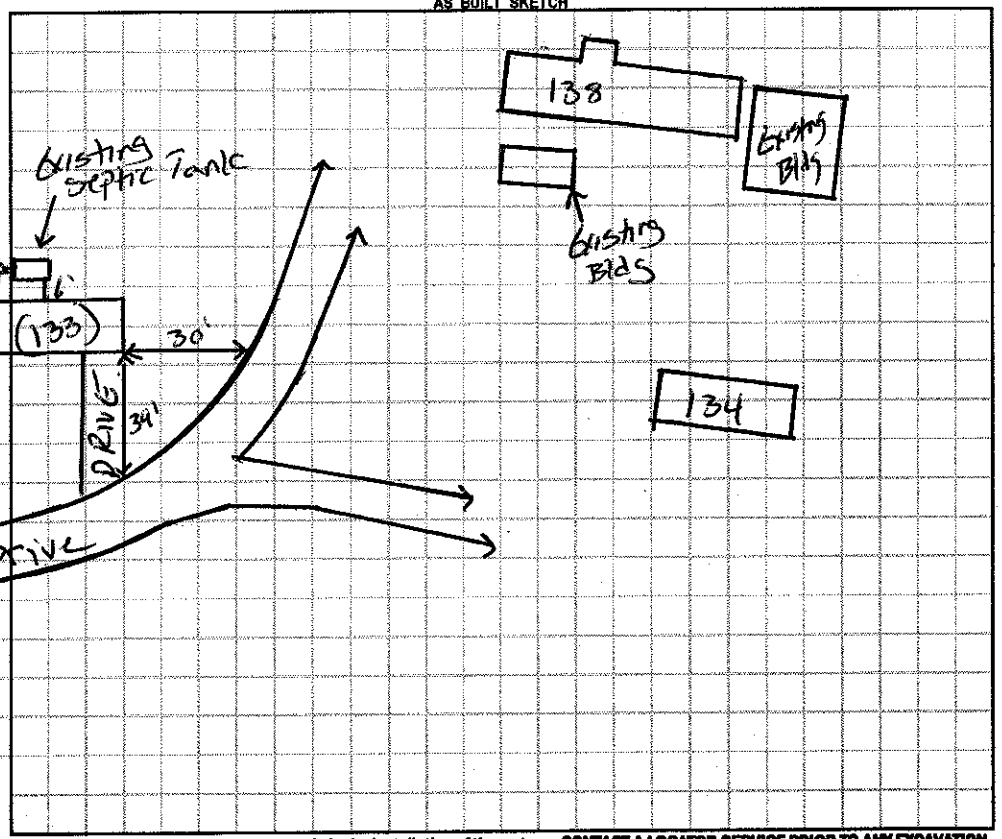

Permit can be suspended or revoked if any false information is supplied toward securing the permit / any unauthorized changes are made to the site / any unauthorized changes are made in the installation of the system. **CONTACT A LOCATOR SERVICE PRIOR TO ANY EXCAVATION**

☐ **IMPROVEMENT PERMIT** *with plat valid without expiration.* ☐ **IMPROVEMENT PERMIT** *with site plan valid for 60 mos.* ☐ **AUTHORIZATION TO CONSTRUCT** *valid for period equal to IMPROVEMENT PERMIT--not to exceed 60 mo.*

Owner / Applicant Signature: Darlene MacFadyen Date: 5-12-16 Installed by:

IMPROVEMENT PERMIT by: Date: OPERATION PERMIT by: Date:

AUTHORIZATION TO CONSTRUCT by: Date: Existing System Inspected by: Justin Henderson Date: 5-10-16

Health Dept. Copy - WHITE Applicant (Final Approval) - YELLOW Applicant (Conditional Approval) - PINK