# IREDELL COUNTY HEALTH DEPARTMENT

STATESVILLE 704-878-5305 (AP) MOORESVILLE 704-664-5281

## IMPROVEMENT PERMIT / AUTHORIZATION TO CONSTRUCT / OPERATION PERMIT / EXISTING SYSTEM INSPECTION

PERMIT # 158665 PIN # 3797-63-3640.134 DATE 10-28-09

OWNER or APPLICANT Madge P. Johnson PHONE: Business ~~828-302-7069~~ Home: 803-786-2938

OWNER or APPLICANT ADDRESS 134 Donald Dr.

LOCATION / DIRECTIONS Taylorsville Hwy, right Midway Rd, Lft Hallyburton, R Donald

SUBDIVISION Lackey MHP BLOCK / SECTION Ex LOT # Ex LOT AREA 8.86 DESIGN FLOW Ex L.T.A.R. Ex

Septic Tank Ex. Gallons: STB ____ Date ____

Pump Tank ____ Gallons: P T ____ Date ____

Pump Make ____ Model ____ Serial # ____

Nitrification Field No Fields Ex No Lines Ex Linear Feet Ex

Trench Width Ex. Max. Trench Bottom Depth Ex Gravel Depth Ex

☐ New System ☐ Repair ☐ Expansion System Type I (II) III IV V VI

System Description: Existing

Repair System Description: ____

Maintenance Agreement Required ☐ YES ☒ NO

☒ GRAVITY ☐ PRESSURE

☒ Residence No. Bedrooms 2

☐ Business No. Persons ____

☐ Other No. Employees ____

☐ Slab ☒ Crawl Space

☐ Basement w/plumbing ☐ Basement w/o plumbing


Water Supply: ☐ Private ☒ Public ☐ Community

Comments / Conditions

Comments / Conditions

INITIAL SITE SKETCH

AS BUILT SKETCH

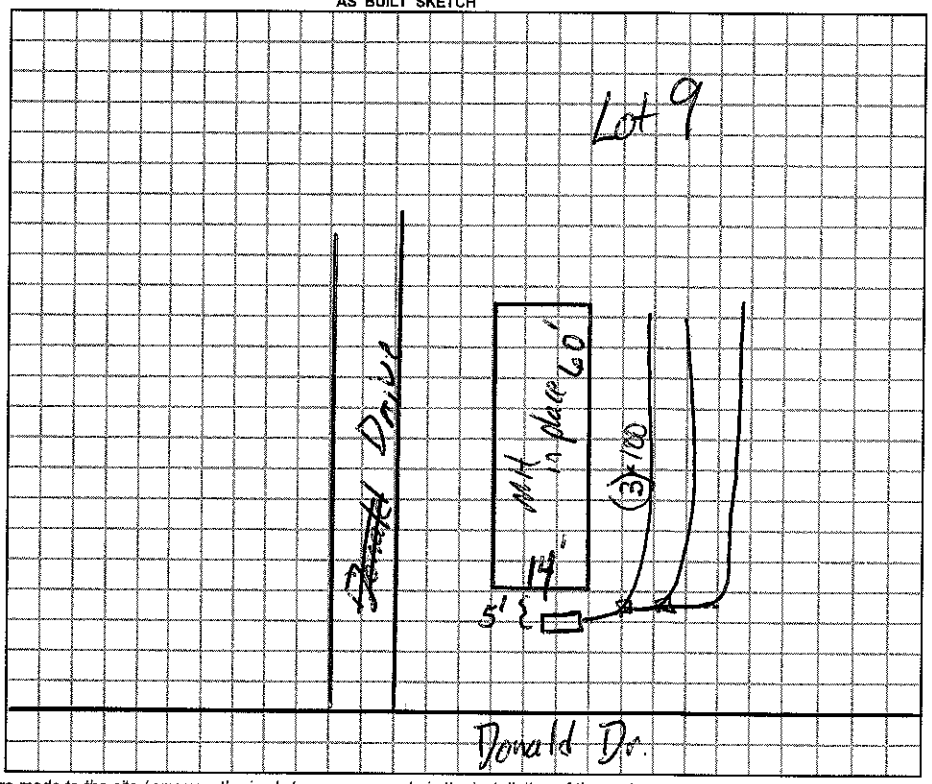


*Permit can be suspended or revoked if any false information is supplied toward securing the permit / any unauthorized changes are made to the site / any unauthorized changes are made in the installation of the system.*

☐ *IMPROVEMENT PERMIT w / plat valid without expiration.* ☐ *IMPROVEMENT PERMIT w / site plan valid for 60 mos.* ☐ *AUTHORIZATION TO CONSTRUCT valid for period equal to IMPROVEMENT PERMIT-not to exceed 60 mo.*

Owner / Applicant Signature: Robert Johnson Date 10-29-09

Improvement Permit by: ____ Date ____

Authorzation to Construct by: ____ Date ____

***YOU SHOULD CONTACT A LOCATOR SERVICE PRIOR TO ANY EXCAVATION.***

Installed by: ____

Operation Permit by: ____ Date: ____

Existing System Inspected by: James ____ Date: 10-28-09

WHITE COPY Environmental Health YELLOW COPY (Final) Owner / Applicant PINK COPY (Initial) Owner / Applicant