IREDELL COUNTY HEALTH DEPARTMENT

STATESVILLE 704-878-5305 MOORESVILLE 704-664-5281

IMPROVEMENT PERMIT / AUTHORIZATION TO CONSTRUCT / OPERATION PERMIT / EXISTING SYSTEM INSPECTION

PERMIT# 142938 PIN# 3797-71-7909 DATE 13 June 07

OWNER OR APPLICANT Terry Combs PHONE: Business 704-585-9602 Home

ADDRESS P.O. Box 741 Stony Point, N.C. 28678

LOCATION 5092 Taylorsville Hwy. Stony Point, N.C.

SUBDIVISION BLOCK / SECTION LOT LOT AREA 11.95 Ac. SITE CLASS. 1P3 DESIGN FLOW 360gpd L.T.A.R. 0.3 g/ft²/d.

Septic Tank: 1000 Gallons; STB 1012-1000 Date 3/14/07
Pump Tank: Gallons; PT Date
Pump Make: Model Serial No.
Nitrification Field: No Fields 1 Square Feet = 1200 Linear Feet 300
No Lines 3 Trench Width 30" Max Trench Bottom Depth 36"

☑ New System ☐ Repair ☐ Expansion System Type: I II III IV V VI
System Description: 25% Reduction
Repair System Description: 25% Reduction
Maintenance Agreement Required: ☐ Yes ☑ No

☐ House/Mod. Home No. Bedrooms 3
☑ Mobile Home No. Persons
☐ Business No. Employees
☐ Other


Water Supply: ☐ Individual ☑ Public ☐ Community

Gravel Depth ☑ Gravity ☐ Pressure ☐ Slab ☑ Crawl Space ☐ Basement w/plumbing ☐ Basement wo/plumbing


Comments:/Conditions:
Follow contour

Comments:/Conditions: Tuff-Tight Tank
Tank has marker

INITIAL SITE SKETCH

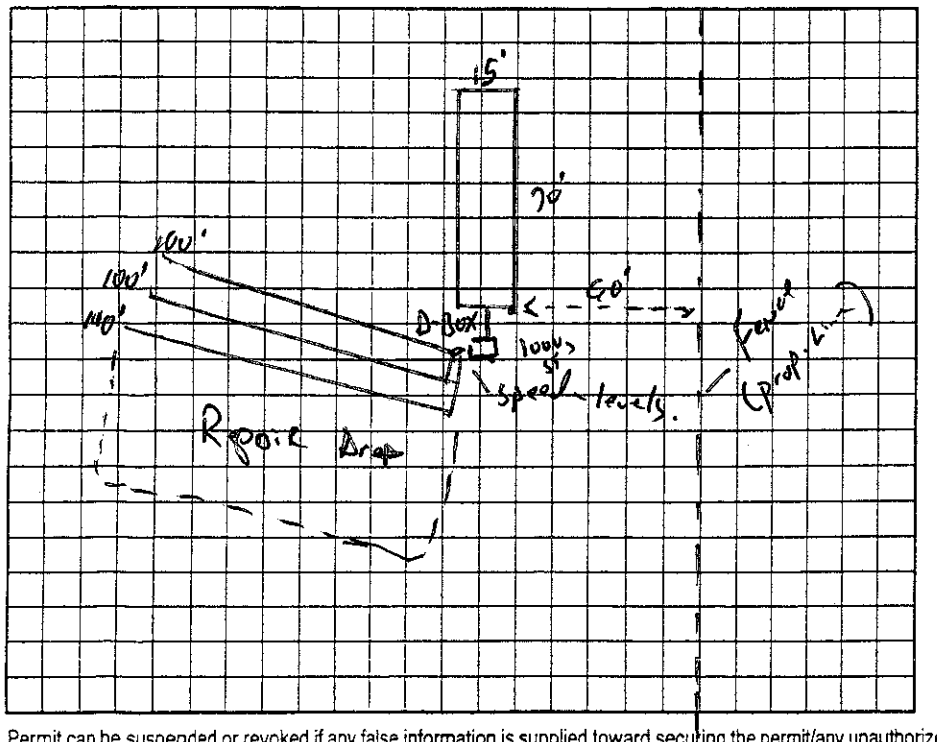

AS BUILT SKETCH

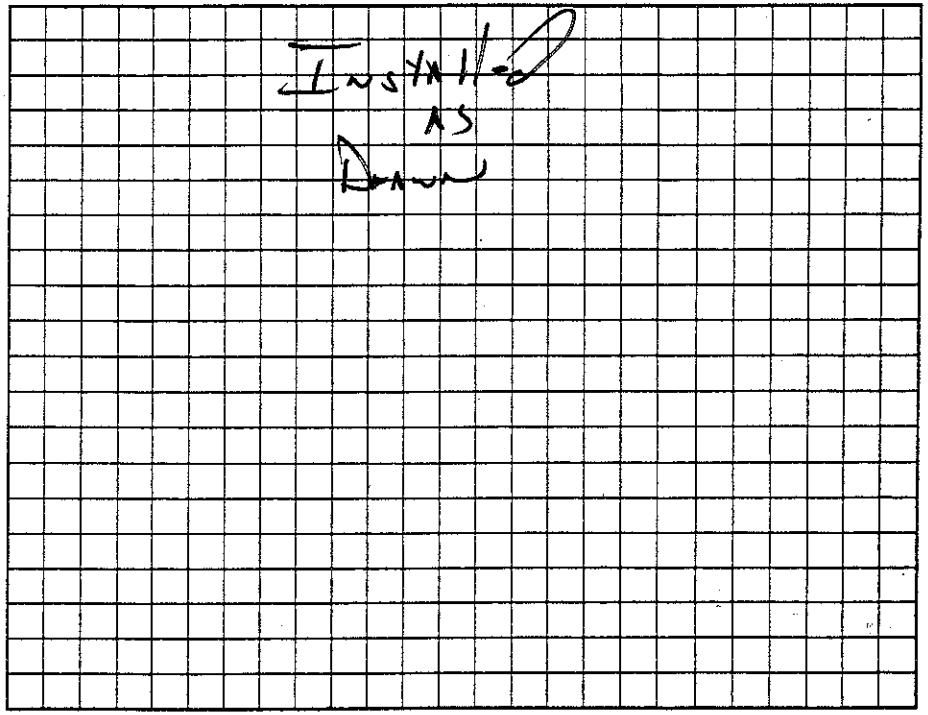

Permit can be suspended or revoked if any false information is supplied toward securing the permit/any unauthorized changes are made to the site/any unauthorized changes are made in the installation of the system. Improvement Permit with plat valid without expiration. ☐ Improvement Permit with site plan valid for sixty months ☑ Authorization to Construct is valid for a period equal to that of Improvement Permit – not to exceed sixty months.

Signed: date 6-20-07 Installed by: Robbie Brown

Improvement Permit by: R.S. date 13 June 07 Operation Permit by: R.S. date 11 Sept. 07

Authorization to Construct by: date 6-20-07 Existing System Inspection by: date

HEALTH DEPT. COPY: WHITE OWNER COPY (FINAL): YELLOW OWNER COPY (INITIAL): PINK