IREDELL COUNTY HEALTH DEPARTMENT

Statesville Phone TR 3-7271 . Mooresville Phone No. 664-5281

PERMIT TO INSTALL SEPTIC TANK

Permit No. _____ Permit Date 9-29 1973

Owner JERRY HAGER TRAILER PARK Address STONY POINT, NC

Installed By LACKEY BROS. Address STONY POINT, NC


Location of Property 90W - TO NEAR STONY POINT, LT BEHIND STONY POINT FURN. CO. - LOT. 1

Tank		Capacity		Length of Lines		Fixtures 2 TRAILERS	
Block	( )	1000	( )	225'	( )	No. of Baths	( )
Precast	(✓)	1250	(✓)	250'	( )	Dishwasher	( )
		1500	( )	Other 400		Garbage Grdr.	( )
		Other _____				Other _____	

NOTIFY HEALTH DEPARTMENT AT LEAST EIGHT HOURS BEFORE TANK IS TO BE INSPECTED.

Final Inspection _____ 19___ Approved (✓) Disapproved ( )

Remarks ALEXANDER WATER CORP

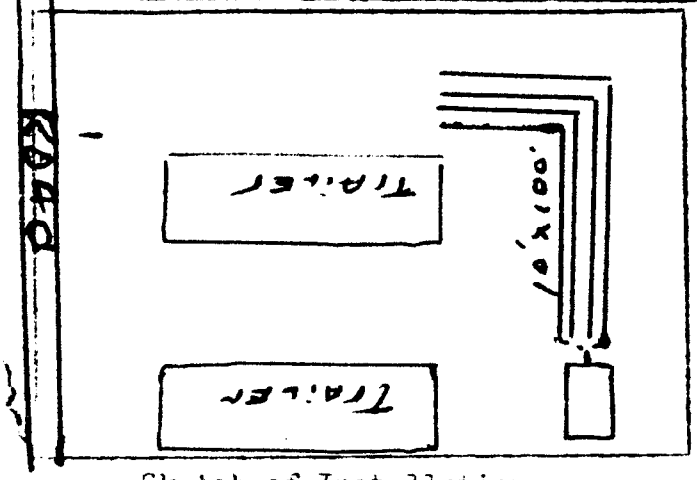

Sketch of Installation

Glenn Ford Jr.

Sanitarian