IREDELL COUNTY HEALTH DEPARTMENT

Statesville Phone TR 3-7271 Mooresville Phone No. 664-5281

PERMIT TO INSTALL SEPTIC TANK

Permit No. _____ Permit Date 13 Sept 1973

Owner Jerry Hagen Address Stony Point, N.C.

Installed By Lackey Burden Address _____


Location of Property Hwy 90 to Stony Point - Turn left behind Stony Point Furniture. Go one to end of street on left. #3

Tank		Capacity		Length of Lines		Fixtures	
Block	( )	1000	( )	225'	( )	No. of Baths	( )
Precast	(✓)	1250	(✓)	250'	( )	Dishwasher	( )
		1500	( )	Other 400'		Garbage Grdr.	( )
		Other _____				Other _____	

NOTIFY HEALTH DEPARTMENT AT LEAST EIGHT HOURS BEFORE TANK IS TO BE INSPECTED.

Final Inspection 13 Sept 1973 Approved (✓) Disapproved ( )

Remarks Two Trailers

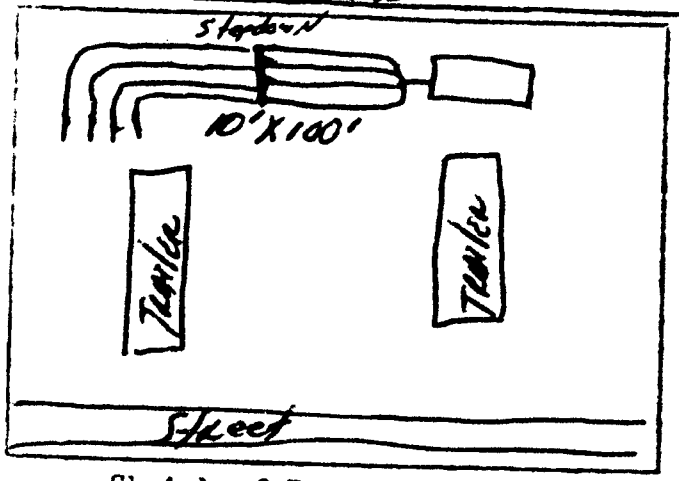

Sketch of Installation

Alexander Water Corp.

William M. Howard
Sanitarian