IREDELL COUNTY HEALTH DEPARTMENT

Statesville Office (704) 878-5305 Mooresville Office (704) 660-3625 PERMIT # 21995

IMPROVEMENT PERMIT / AUTHORIZATION TO CONSTRUCT / OPERATION PERMIT / EXISTING SYSTEM

PIN # 3797-73-3256.000

APPLICANT: TONI T. CAGLE APPLICANT ADDRESS: 210 HALY BURTON RD. STANLY POINT NC

SITE ADDRESS: 210 HALYBURTON RD. STANLY POINT NC PHONE: 704-585-2567 ALT. PHONE: 704-880-4333

SITE DIRECTIONS: Hwy 90 W. To STANLY POINT TR MIDWAY, TL HALY BURTON, SITE ON R ACROSS FROM WELDING SHOP


SUBDIVISION: SECTION: LOT # LOT AREA: 9 ACRE DESIGN FLOW: 360 GPD L.T.A.R.: .3 I / .25 R

Septic Tank	1000	(gal)	STB	160	Date	7/27/16	☐ New System	☒ Repair	☐ Expansion	System Type: I II III IV V VI	
Pump Tank		(gal)	PT		Date		System Description:	25% REDUCTION-GRAVITY			
Pump Make			Model		Serial #		Repair System Description:	C-PPRPS			
# Nitrification Fields	1		# Lines	3 @ 100'	Linear Ft:	300'	Maintenance Agreement Required:	☐ YES	☒ NO		
Trench Width	36"		Max. Trench Bottom Depth	36"	Gravel Depth	N/A	☒ GRAVITY	☐ PRESSURE			


☒ Residence	No. Bedrooms	3	Water Supply	
☐ Business	No. Persons	6	☐ Private	
☐ Other	No. Employees		☒ Public	
☐ Slab	☒ Crawl Space		☐ Community	
☐ Basement w/plumbing			☐ Basement w/o plumbing	

Comments / Conditions: NEW LINES TO BE 9' ON CENTER FROM EXISTING LINES. CRUSH & FILL EXISTING TANK AND SET NEW TANK WHERE SHOWN. SMOOTH/FILL ANY DEPRESSIONS IN SEPTIC AREA.

INITIAL SITE SKETCH

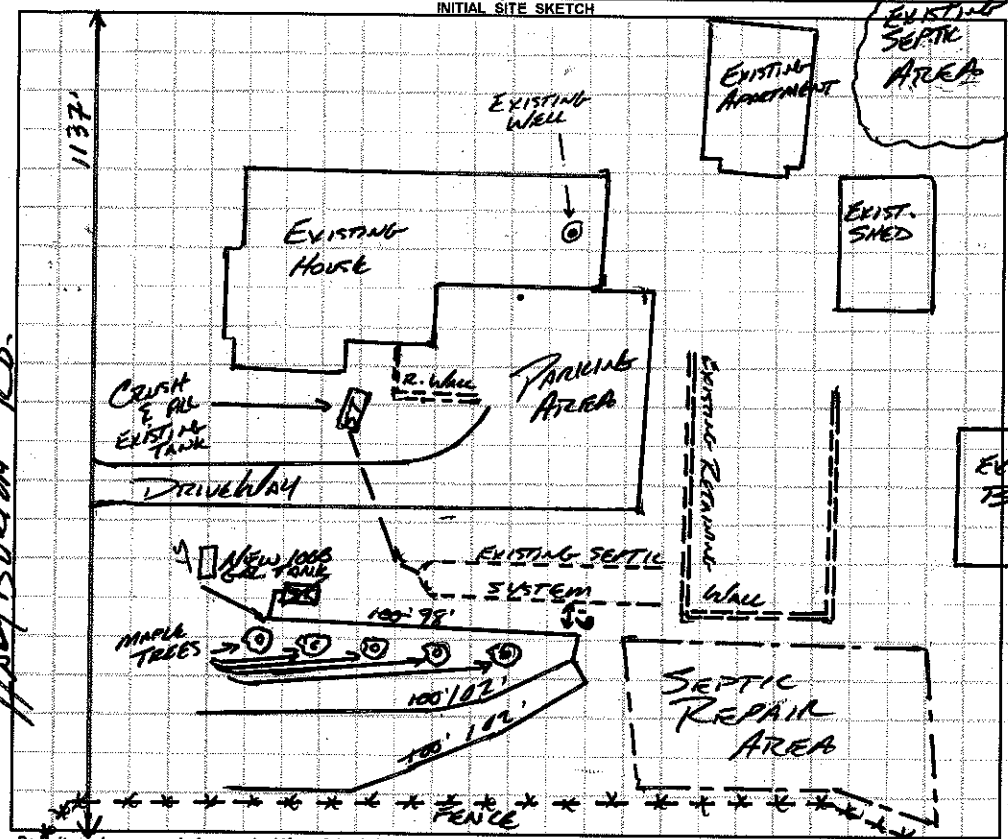

AS BUILT SKETCH

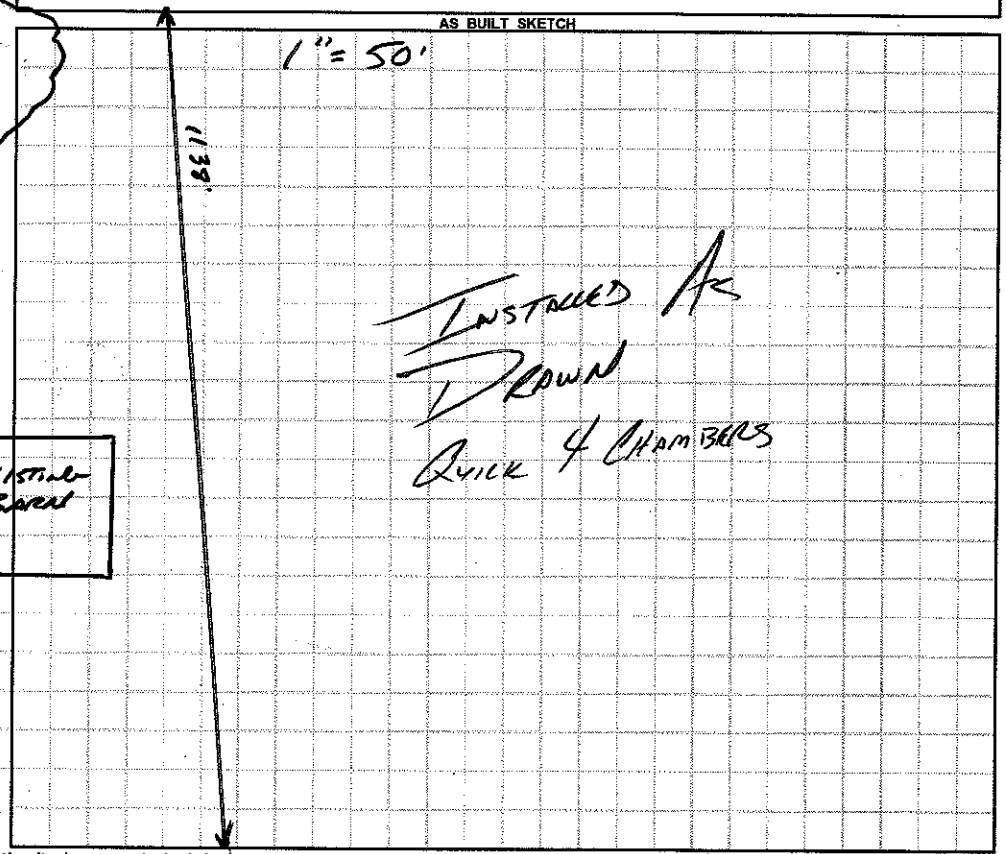

Permit can be suspended or revoked if any false information is supplied toward securing the permit / any unauthorized changes are made to the site / any unauthorized changes are made in the installation of the system. **CONTACT A LOCATOR SERVICE PRIOR TO ANY EXCAVATION**

☐ **IMPROVEMENT PERMIT** *with plat valid without expiration.* ☒ **IMPROVEMENT PERMIT** *with site plan valid for 60 mos.* ☒ **AUTHORIZATION TO CONSTRUCT** *valid for period equal to IMPROVEMENT PERMIT--not to exceed 60 mo.*

Owner / Applicant Signature: Date: 7/15/16 Installed by: K & B GRADING

IMPROVEMENT PERMIT by: APPROVED JUL 12 2016 OPERATION PERMIT by: Date: 7/19/16

AUTHORIZATION TO CONSTRUCT by: APPROVED JUL 12 2016 Existing System Inspected by: Date:

Health Dept. Copy - WHITE Applicant (Final Approval) - YELLOW Applicant (Conditional Approval) - PINK