IREDELL COUNTY HEALTH DEPARTMENT

STATESVILLE 704-878-5305 MOORESVILLE 704-664-5281

IMPROVEMENT PERMIT / AUTHORIZATION TO CONSTRUCT / OPERATION PERMIT / EXISTING SYSTEM INSPECTION

PERMIT # 155511 PIN # 3799789487 8582 DATE

OWNER or APPLICANT Daisy Chatham PHONE: Business Home: 704-873-2547

OWNER or APPLICANT ADDRESS 269 Stikeleather Stanley Post

LOCATION / DIRECTIONS 90W to Midway to Stikeleather NC 28678

SUBDIVISION Barr BLOCK / SECTION LOT # 1 LOT AREA 1.43 DESIGN FLOW 360 L.T.A.R. .25

Septic Tank 1000 Gallons: STB 760 Date 9-30-08 ☑ New System ☐ Repair ☐ Expansion System Type I II III IV V VI

Pump Tank Gallons: P T Date System Description: 25% Gravel

Pump Make Model Serial # Repair System Description: 50% Low Pressure

Nitrification Field No Fields No Lines Linear Feet 360 Maintenance Agreement Required ☐ YES ☑ NO

Trench Width 36" Max. Trench Bottom Depth 24" Gravel Depth ☑ GRAVITY ☐ PRESSURE

☐ Residence No. Bedrooms 3 ☐ Business No. Persons ☐ Other No. Employees ☐ Slab ☑ Crawl Space ☐ Basement w/plumbing ☐ Basement w/o plumbing


Water Supply: ☐ Private ☑ Public ☐ Community

Comments / Conditions

Comments / Conditions

Contact on Contour
Maintain all setback


INITIAL SITE SKETCH

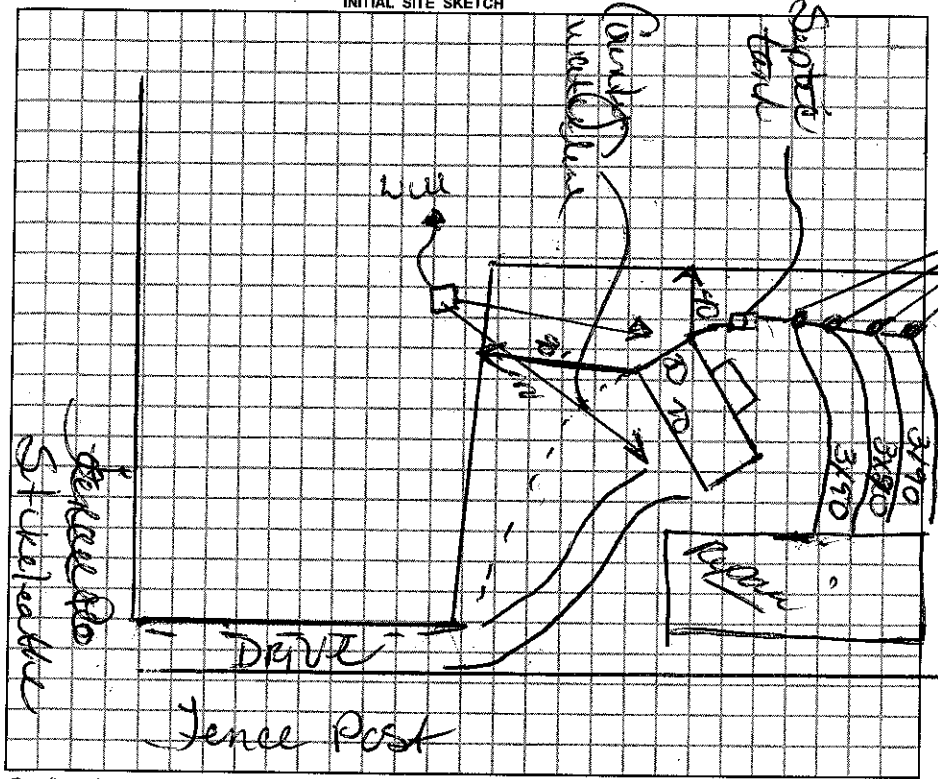

AS BUILT SKETCH

24" Juncl bottom

SEPTIC TANK W/ MARKER INSTALLED
W/ POLY LOK FILTER
ANGLE OF HOUSE CHANGED SLIGHTLY

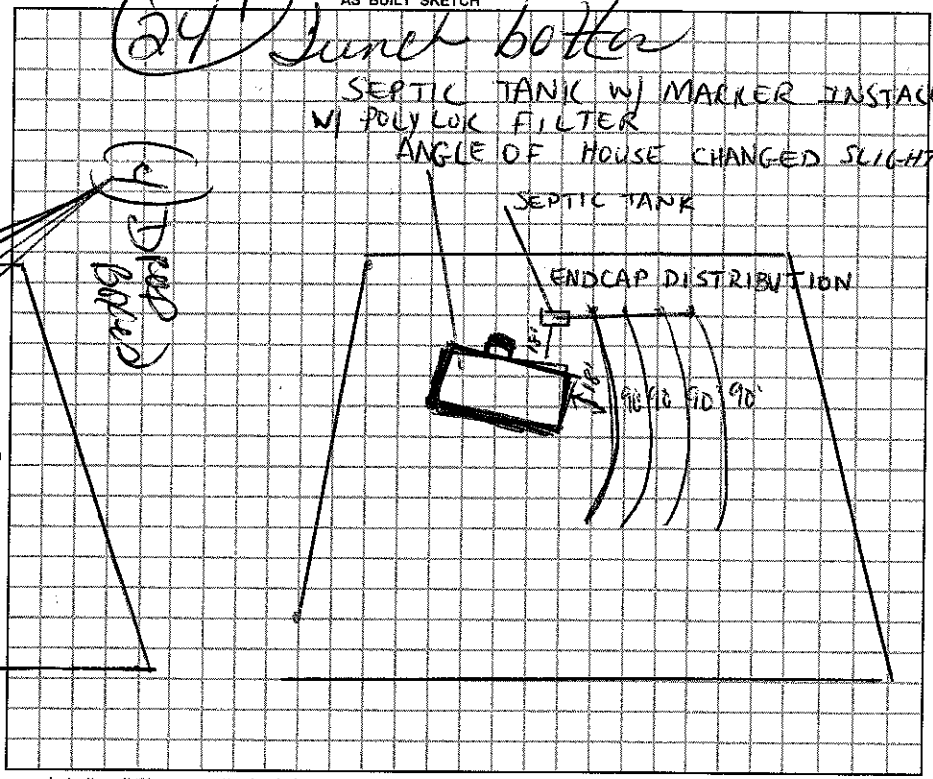

Permit can be suspended or revoked if any false information is supplied toward securing the permit / any unauthorized changes are made to the site / any unauthorized changes are made in the installation of the system.

☐ *IMPROVEMENT PERMIT w / plat valid without expiration* ☐ *IMPROVEMENT PERMIT w / site plan valid for 60 mos.* ☑ *AUTHORIZATION TO CONSTRUCT valid for period equal to IMPROVEMENT PERMIT-not to exceed 60 mo.*

Owner / Applicant Signature: Date 3-24-09

Improvement Permit by: Date 3-24-09

Authorzation to Construct by: Date 3-24-09

Installed by: Abbres Grading

Operation Permit by: Date: 4-7-09

Existing System Inspected by: Date:

YOU SHOULD CONTACT A LOCATOR SERVICE PRIOR TO ANY EXCAVATION.

WHITE COPY Environmental Health YELLOW COPY (Final) Owner / Applicant PINK COPY (Initial) Owner / Applicant