* Repair

IREDELL COUNTY HEALTH DEPARTMENT

STATESVILLE 704-878-5305 MOORESVILLE 704-664-5281

IMPROVEMENT PERMIT / AUTHORIZATION TO CONSTRUCT / OPERATION PERMIT / EXISTING SYSTEM INSPECTION

PERMIT# Repair PIN# 3797-81-1996 95 DATE 29 March 07

OWNER OR APPLICANT Alex Armington PHONE: Business 704-929-1062 Home

ADDRESS 5081 Taylorsville Hwy. Statesville, N.C.

LOCATION Taylorsville Hwy on left past Captains Colly on left.

SUBDIVISION BLOCK / SECTION LOT LOT AREA 12 Ac. SITE CLASS. P3 DESIGN FLOW 360 gpd L.T.A.R. 0.3 gpd/ft²

Septic Tank: Ex. Gallons: STB Ex. Date Ex

Pump Tank: Gallons: PT Date

Pump Make: Model Serial No.

Nitrification Field: No Fields 1 Square Feet 1200 Linear Feet 300

No Lines 5 Trench Width 36" Max Trench Bottom Depth 30" Gravel Depth

☐ New System ☑ Repair ☐ Expansion System Type: I (II) III IV V VI

System Description: 25% Reduction

Repair System Description:

Maintenance Agreement Required: ☐ Yes ☒ No

☑ House/Mod. Home No. Bedrooms 3

☐ Mobile Home No. Persons

☐ Business No. Employees

☐ Other

Water Supply: ☐ Individual ☑ Public ☐ Community

☑ Gravity ☐ Pressure ☐ Slab ☐ Crawl Space ☐ Basement w/plumbing ☑ Basement wo/plumbing

Comments:/Conditions: Follow contour / 400' of conventional gravel system may also be used

INITIAL SITE SKETCH

If existing tank needs to be replaced after inspecting tank. It may be replaced with a new 1000 gallon tank. See attached diagram

Comments:/Conditions: Brown Filter

AS BUILT SKETCH

New Tank STB 1000 3-9-07

45

300'

as shown on permit

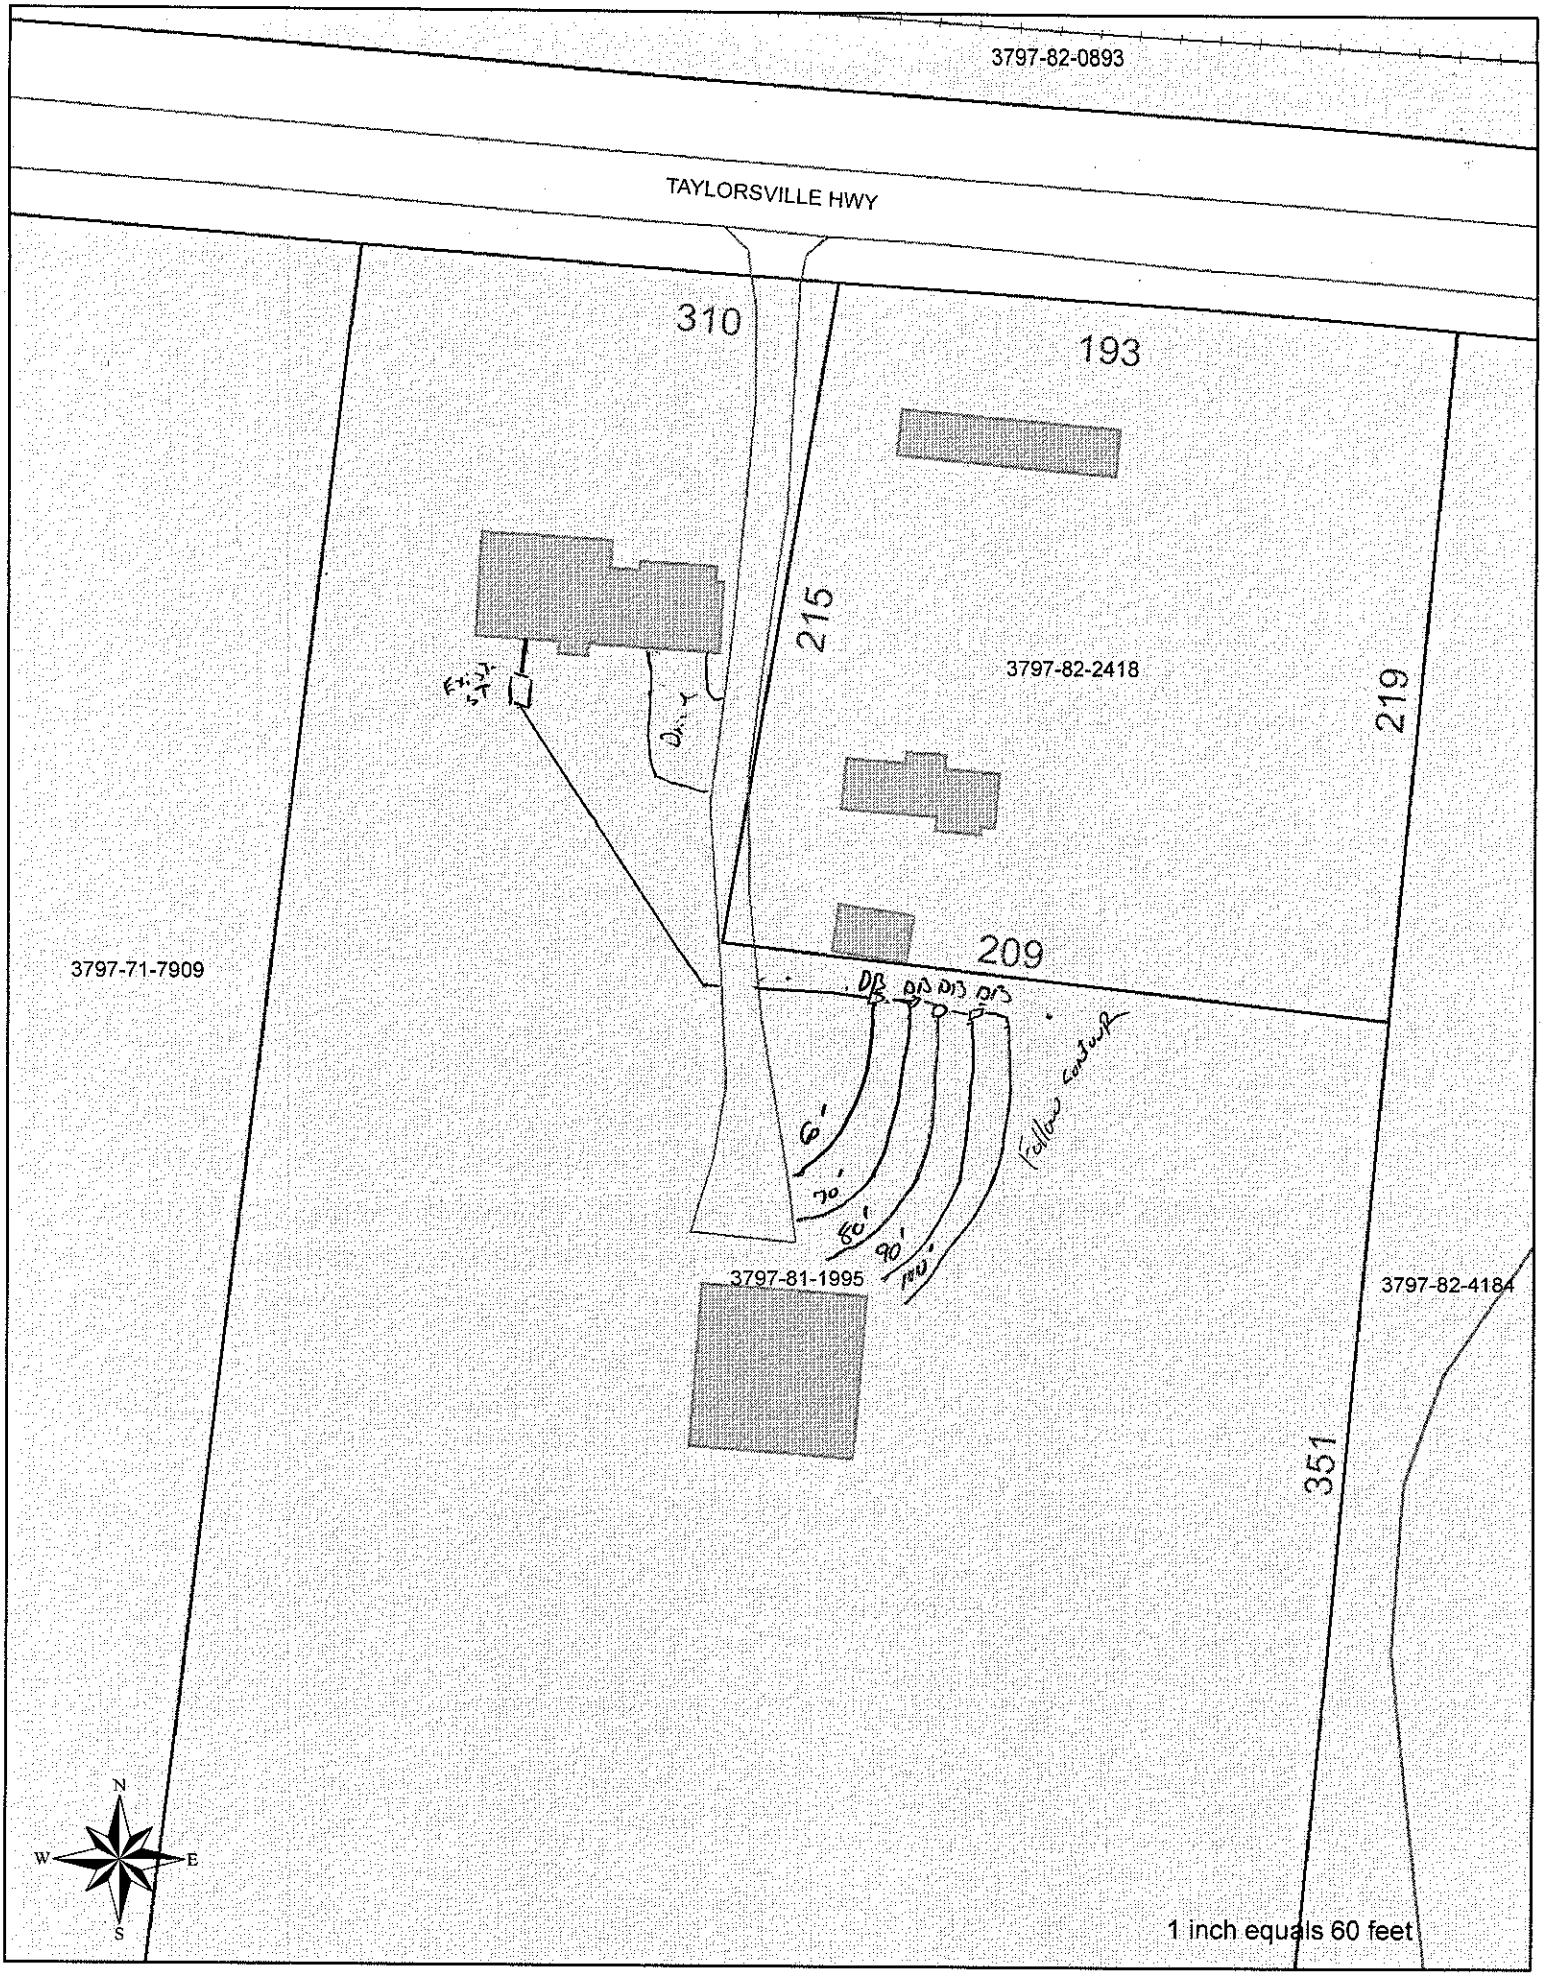
Permit can be suspended or revoked if any false information is supplied toward securing the permit/any unauthorized changes are made to the site/any unauthorized changes are made in the installation of the system. Improvement Permit with plat valid without expiration ☐ Improvement Permit with site plan valid for sixty months ☐ Authorization to Construct is valid for a period equal to that of Improvement Permit – not to exceed sixty months.

Signed: date 4-17-07 Installed by: Andy Daniels

Improvement Permit by: date 4-17-07 Operation Permit by: date 4-18-07

Authorization to Construct by: date 4-17-07 Existing System Inspection by: date

HEALTH DEPT. COPY: WHITE OWNER COPY (FINAL): YELLOW OWNER COPY (INITIAL): PINK


3797-82-0893
TAYLORSVILLE HWY
310
193
215
219
209
351
3797-82-2418
3797-71-7909
3797-81-1995
3797-82-4184
Existing
Drive
DP
DP
DP
DP
Follow contour
60'
70'
80'
90'
100'
N
W
E
S
1 inch equals 60 feet