IREDELL COUNTY HEALTH DEPARTMENT

STATESVILLE 704-878-5305 MOORESVILLE 704-664-5281

IMPROVEMENT PERMIT / AUTHORIZATION TO CONSTRUCT / OPERATION PERMIT / EXISTING SYSTEM INSPECTION

PERMIT# 058400 PIN# Tax map 7J-B-26 DATE 2-19-98

OWNER OR CONTRACTOR Carolina Woodworks PHONE: Business 595 6373 Home

ADDRESS @ 165 Halyburton Rd Stony Point, N.C.

LOCATION 90 west TR Midway Rd To Halyburton 1st business left

SUBDIVISION BLOCK / SECTION LOT LOT AREA 22.9 acres SITE CLASS. DESIGN FLOW 625 L.T.A.R. .35

Septic Tank: 1500 Gallons; STB 268 Date 12-24-97

Pump Tank: 1500 Gallons; PT 247 Date 11-3-97

Pump Make: Liberty Model LE102 Serial No. 5642

Nitrification Field: No Fields 1 Square Feet 1800 Linear Feet 600

No Lines 4 Trench Width 36" Max Trench Bottom Depth 36" Gravel Depth 12"

☐ New System ☑ Repair System Type: I, II, III, IV, V, VI

System Description: Pump To Conv. Lines

Repair System Description: " " "

Maintenance Agreement Required: ☐ Yes ☐ No

☐ House/Mod. Home No. Bedrooms

☐ Mobile Home No. Bathrooms

☑ Business No. Employees 25

☐ Other

☐ Slab ☑ Crawl Space ☐ Basement w/plumbing ☐ Basement wo/plumbing


Water Supply: ☑ Individual ☐ Public ☐ Community

Comments:/Conditions: moving office To New location


Replacing P.T. + S.T. To accomodate New office location

Comments:/Conditions:

INITIAL SITE SKETCH

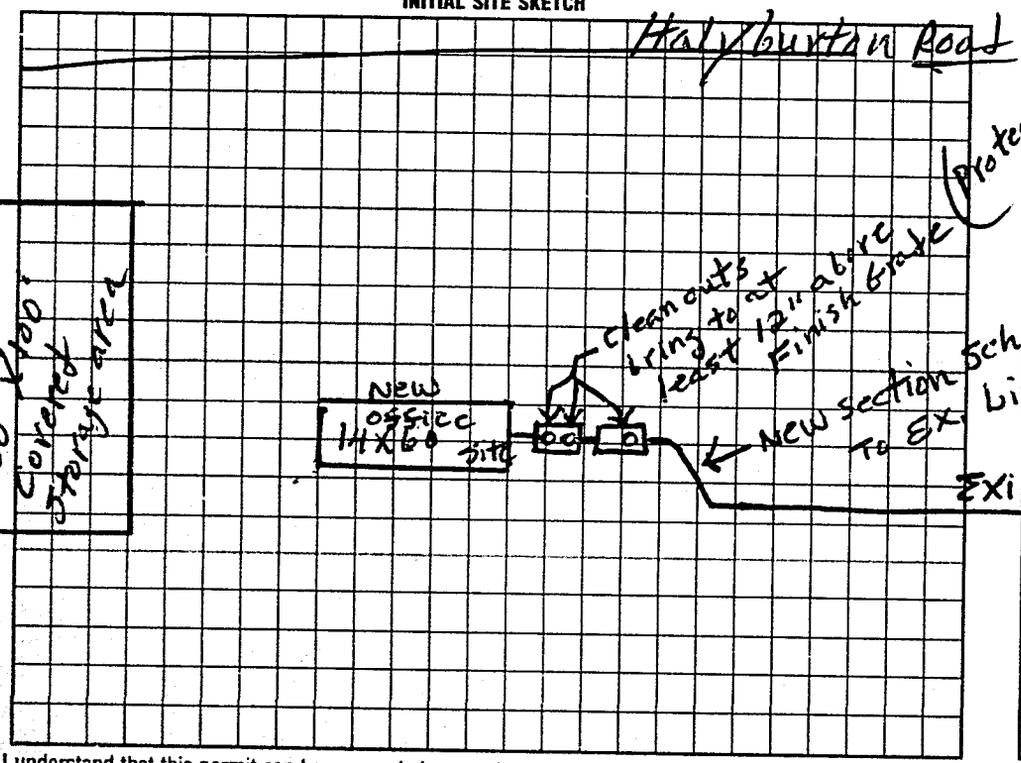

AS BUILT SKETCH

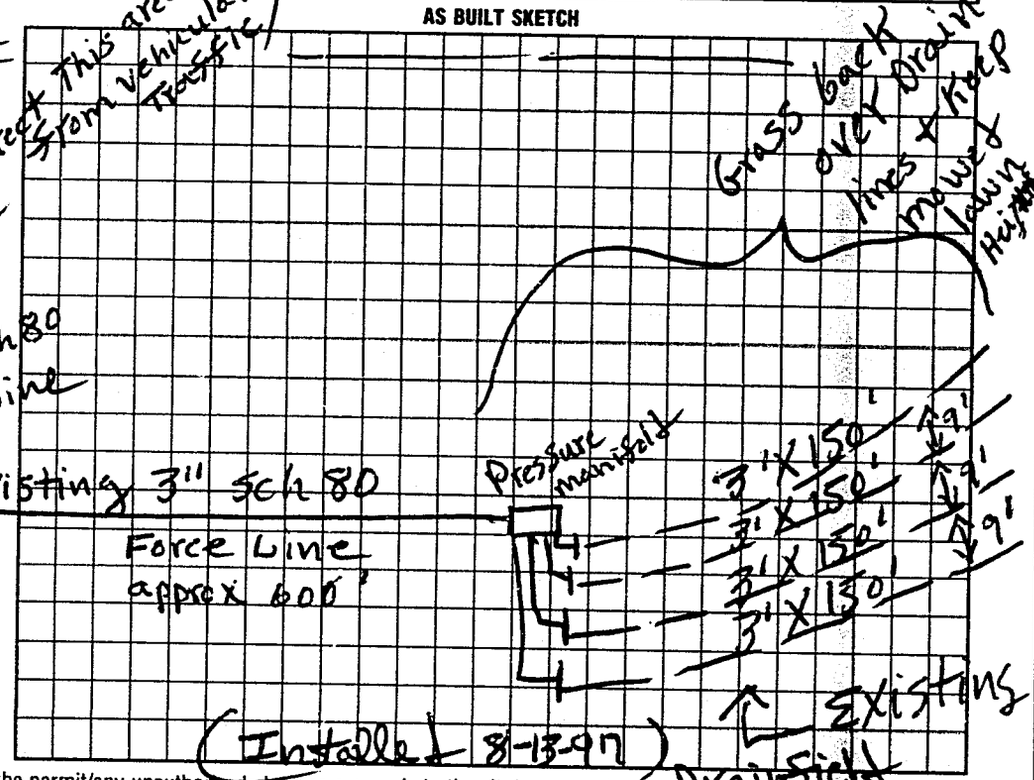

I understand that this permit can be suspended or revoked if any false information is supplied toward securing the permit/any unauthorized changes are made to the site/any unauthorized changes are made in the installation of the system. Improvement Permit with plat valid without expiration. Improvement Permit with site plan valid for sixty months. Authorization to Construct is valid for a period equal to that of Improvement Permit – not to exceed sixty months.

Signed: date

Improvement Permit by: P.C. Moore date 2-19-98

Authorization to Construct by: P.C. Moore date 2-19-98

Installed by: James Hutler

Operation Permit by: P.C. Moore date 3-4-98

Existing System Inspection by date

HEALTH DEPT. COPY: WHITE INSPECTION COPY (FINAL): GREEN OWNER COPY (FINAL): YELLOW INSPECTION COPY (INITIAL): PINK OWNER COPY (INITIAL): GOLD