IREDELL COUNTY HEALTH DEPARTMENT

STATESVILLE 704-878-5305 MOORESVILLE 704-664-5281

IMPROVEMENT PERMIT / CERTIFICATE OF COMPLETION / OPERATION PERMIT / EXISTING SYSTEM INSPECTION

PROPERTY DESCRIPTION NO 2-1880 05 9400 DATE 12-21-95 TAX MAP NO 7J-B-26 Watershed: ☐ Yes ☒ No

OWNER OR CONTRACTOR Carolina Woodworks PHONE: Business 704-465-4112 Home

ADDRESS Rt 16 Box 347 Statesville

LOCATION 90 W TR Midway Rd TL Halyburton 1st business left

SUBDIVISION BLOCK / SECTION LOT LOT AREA 22.9 acres SITE CLASS PS DESIGN FLOW 625 L.T.A.R .35

Septic Tank: 1500 Gallons: STB 1797 Date 12-30-95
Pump Tank: 1500 Gallons: PT 141 Date 3-15-96
Pump Make: Liberty Model LE102 Serial No 5642
Nitrification Field: No Fields 1 Square Feet 1800 Linear Feet 600
No Lines 4 Trench Width 36" Max Trench Bottom Depth 36" Gravel Depth 12"

☒ New System ☐ Repair System Type I II III IV V
System Description: Pump to conv. lines
Repair System Description: " " " "
Maintenance Agreement Required Yes No
Slab ☒ Crawl Space Basement w/plumbing Basement wo/plumbing


House/Mod. Home No. Bedrooms
Mobile Home No. Bathrooms
☒ Business No Employees 25
Other

Water Supply: ☒ Individual ☐ Community ☐ Public


Comments: Replaces permit issued 8-25-95 — see Attached sheets for Pump Tank + Pressure manifold Set up

Comments 2-26-96 Inspected Drain lines + sch 80 solid line pcm
4-2-96 Checked Pump + manifold + Draw Down + Tank leakage

INITIAL SITE SKETCH

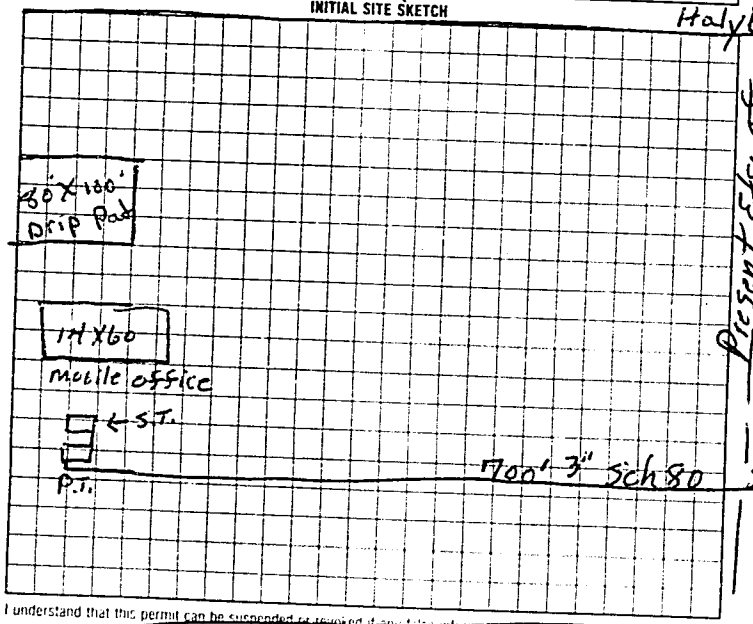

AS BUILT SKETCH Actual 100/min 33.2

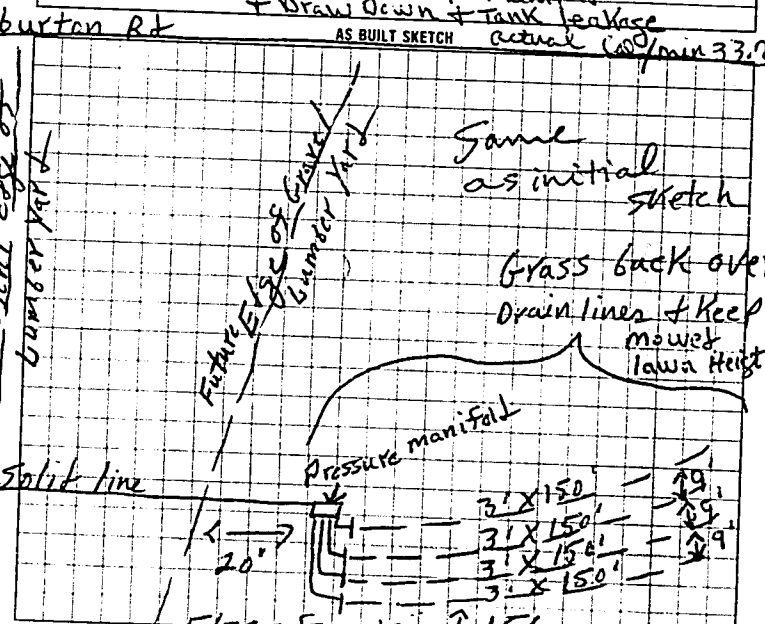

I understand that this permit can be suspended or revoked if any false information is supplied for and securing the permit, any unauthorized changes are made to the site, any unauthorized changes are made in the installation of the system

Signed

Improvement Permit by P.C. moore date 12-21-95
Authorization to Const. by P.C. moore date 12-21-95
Existing System Inspection by
HEALTH DEPT COPY WHITE INSPECTION COPY (FINAL) GREEN OWNER COPY (FINAL) YELLOW

Installed by James Hutler
Certificate of Completion by date
Operation Permit by P.C. moore date 8-13-97
INSPECTION COPY (INITIAL) PINK OWNER COPY (INITIAL) GOLD

Authorization to Const. Expires 60 mos from issue