Locke Lane Properties

206594

IREDELL COUNTY HEALTH DEPARTMENT

STATESVILLE 704-878-5305 (O) (@) MOORESVILLE 704-664-5281

IMPROVEMENT PERMIT / AUTHORIZATION TO CONSTRUCT / OPERATION PERMIT / EXISTING SYSTEM INSPECTION

PERMIT # 162899 PIN # 3797-82-4184 DATE 2 September 10

OWNER or APPLICANT Andrew Sherrill / Locklane Corp PHONE: Business (704) 902-9083 Home: (704) 876-1580

OWNER or APPLICANT ADDRESS 2508 South Chipley Ford Rd Statesville

LOCATION / DIRECTIONS 5063 Taylorsville Hwy / Stoney Point, N.C.

SUBDIVISION BLOCK / SECTION LOT # LOT AREA 10ac. DESIGN FLOW 175gpd

new Septic Tank 1000 Gallons: STB 760 Date 7-18-10

Pump Tank Gallons: PT Date

Pump Make Model Serial #

Exist Nitrification Field No Fields No Lines Linear Feet

Trench Width Max. Trench Bottom Depth Gravel Depth

☑ New System ☐ Repair ☐ Expansion System Type I II III IV V VI

System Description: Exist. Conventional

Repair System Description: 25% Reduction - Pump.

Maintenance Agreement Required ☐ YES ☒ NO

☑ GRAVITY ☐ PRESSURE

☐ Residence No. Bedrooms

☑ Business No. Persons

☐ Other No. Employees 5

☐ Slab ☐ Crawl Space

☑ Basement w/plumbing ☐ Basement w/o plumbing


Water Supply: ☐ Private ☑ Public ☐ Community

Comments / Conditions: Replace existing block septic tank with New Precast tank. / Keep 5' from building. Replumb into existing system.


Comments / Conditions: * Old Permit attached.

* New building with 5 offices and 5 employees.

INITIAL SITE SKETCH

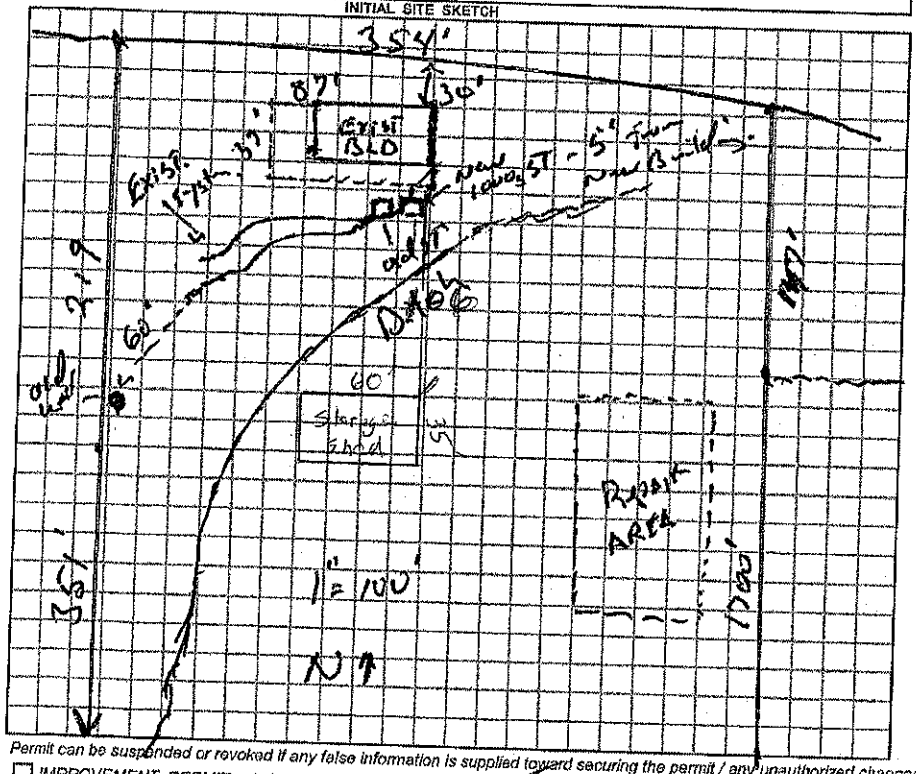

AS BUILT SKETCH

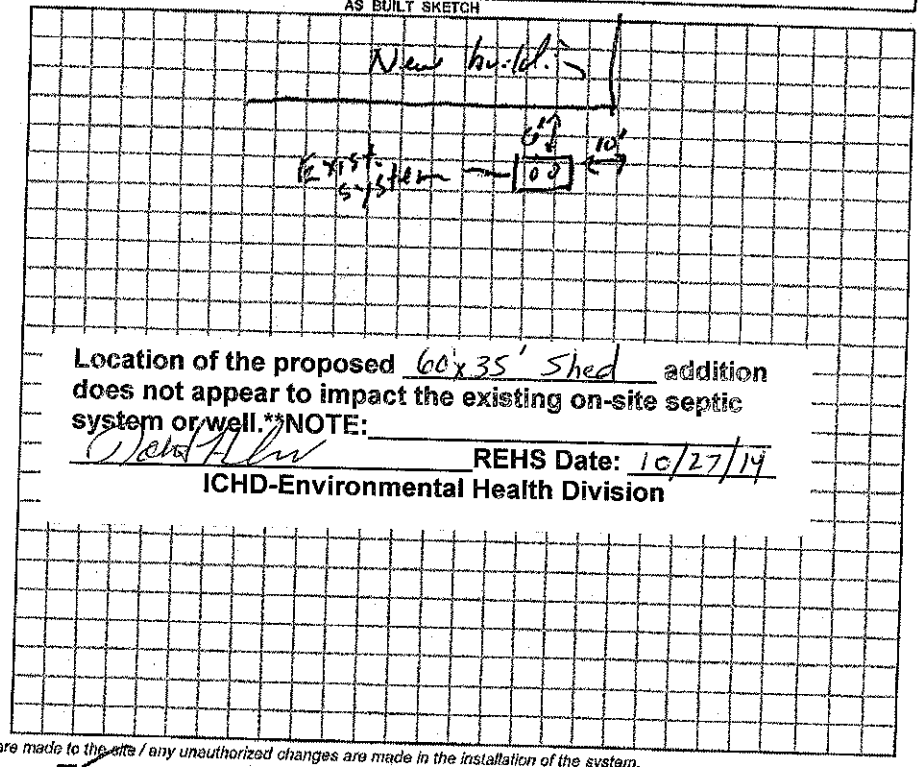

Location of the proposed 60'x35' Shed addition does not appear to impact the existing on-site septic system or well.**NOTE:


ICHD-Environmental Health Division

Permit can be suspended or revoked if any false information is supplied toward securing the permit / any unauthorized changes are made to the site / any unauthorized changes are made in the installation of the system.

☐ IMPROVEMENT PERMIT w / plat valid without expiration. ☑ IMPROVEMENT PERMIT w / site plan valid for 60 mos.

☑ AUTHORIZATION TO CONSTRUCT valid for period equal to IMPROVEMENT PERMIT-not to exceed 60 mo.

Owner / Applicant Signature: Date 9-2-10

Improvement Permit by: R.S Date 2 Sept. 10

Authorization to Construct by: R.S. Date 2 Sept. 10

YOU SHOULD CONTACT A LOCATOR SERVICE PRIOR TO ANY EXCAVATION.

Installed by: A-1 Backhoe

Operation Permit by: R.S. Date: 8 Feb. 11

Existing System Inspected by: Date:

WHITE COPY Environmental Health YELLOW COPY (Final) Owner / Applicant PINK COPY (Initial) Owner / Applicant