IREDELL COUNTY HEALTH DEPARTMENT

STATESVILLE 704-878-5305 MOORESVILLE 704-664-5281

IMPROVEMENT PERMIT / AUTHORIZATION TO CONSTRUCT / OPERATION PERMIT / EXISTING SYSTEM INSPECTION

PERMIT# 093460 PIN# 3797 83 0169 DATE 3/19/01

OWNER OR CONTRACTOR FLEETWOOD HOMES PHONE: Business (704) 528-7120 Home

ADDRESS 1040 CHARLOTTE HWY. TROUTMAN, NC 28166

LOCATION N.C. 90 ® MIDWAY ® HALYBURTON LOT ON ®

SUBDIVISION A BLOCK / SECTION LOT 14 LOT AREA .57 Ac. SITE CLASS P DESIGN FLOW 360 GPD L.T.A.R. .30

Septic Tank: 1000 Gallons: STB 372 Date 1-6-01
Pump Tank: 1000 Gallons: PT 293 Date 2-9-01
Pump Make: Hydromatic Model SKV50 Serial No 51925-010-9
Nitrification Field: No Fields 1 Square Feet 900 Linear Feet 300'
No Lines 4 Trench Width 3' Max Trench Bottom Depth 30" Gravel Depth N/A

☒ New System ☐ Repair System Type: I, II, (III), IV, V, VI
System Description: 25% REDUCTION
Repair System Description: SAME
Maintenance Agreement Required: ☐ Yes ☐ No

☐ House/Mod. Home ☒ Mobile Home ☐ Business ☐ Other
No. Bedrooms 3 No. Bathrooms 2 No. Employees


☐ Slab ☒ Crawl Space ☐ Basement w/plumbing ☐ Basement wo/plumbing

Water Supply: ☐ Individual ☒ Public ☐ Community

Comments/Conditions: ① NO CUTTING OR FILLING OVER DRAINFIELD/REPAIR AREAS ② KEEP ALL DRAINS AWAY FROM DRAINFIELD/REPAIR AREAS ③ MAINTAIN NOTED SETBACKS ④ CONTACT HEALTH DEPT. PRIOR TO INSTALLATION.

Comments/Conditions: Septic Tank Multiger, Septic Tank Riser - Poly Lok Filter Installed, Pump Tank Riser Installed - Installed w/50% Infiltrator Chambers (3/26/01 Wfg)

INITIAL SITE SKETCH

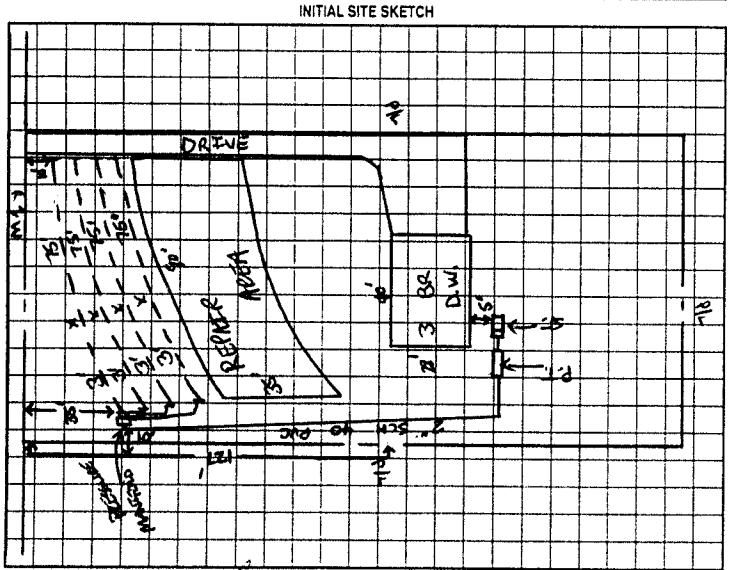

AS BUILT SKETCH

Installed as per Initial Site Sketch

Permit can be suspended or revoked if any false information is supplied toward securing the permit/any unauthorized changes are made to the site/any unauthorized changes are made in the installation of the system. Improvement Permit with plat valid without expiration. Improvement Permit with site plan valid for sixty months. Authorization to Construct is valid for a period equal to that of Improvement Permit – not to exceed sixty months.

Signed: Agent at Freedom Homes date 3/20/01

Improvement Permit by: date 3/19/01

Authorization to Construct by: date 3/19/01

~~Installed by~~ Operation Permit: William O Johnson X57 date 4/11/01

~~Installed by~~ Operation Permit: Marty Tucker date 3/26/01

Existing System Inspection by: date

HEALTH DEPT COPY WHITE OWNER COPY (FINAL) YELLOW OWNER COPY (INITIAL) PINK