IREDELL COUNTY HEALTH DEPARTMENT

STATESVILLE 704-878-5305 MOORESVILLE 704-664-5281

IMPROVEMENT PERMIT / AUTHORIZATION TO CONSTRUCT / OPERATION PERMIT / EXISTING SYSTEM INSPECTION

PERMIT# 087487 PIN# 3797 83 61666 DATE 1-31-00

OWNER OR CONTRACTOR STEPHEN W. ORRELL PHONE: Business Home 489-1319

ADDRESS 6350 SANDY RIDGE LANE, DENVER NC 28037

LOCATION NC 90 W, TR MIDWAY RD, TL HALYBURTON ROAD, 5TH LOT ON RIGHT

SUBDIVISION HALYBROOK BLOCK / SECTION LOT 9 LOT AREA 0.568 ACRE SITE CLASS PS DESIGN FLOW 360 L.T.A.R. 0.30 gpd/ft2

Septic Tank: 1000 Gallons; STB 312 Date 11-15-99

Pump Tank: Gallons; PT Date

Pump Make: Model Serial No.

Nitrification Field: No Fields 1 Square Feet 1200 Linear Feet 400

No Lines FIVE Trench Width 36" Max Trench Bottom Depth 36" Gravel Depth 12"

☑ New System ☐ Repair System Type: I II III IV V VI

System Description: CONVENTIONAL GRAVITY

Repair System Description: CONVENTIONAL PUMP

Maintenance Agreement Required: ☐ Yes ☑ No

☐ House/Mod. Home ☑ Mobile Home ☐ Business ☐ Other

No. Bedrooms 3 No. Bathrooms 2 No. Employees


☐ Slab ☑ Crawl Space ☐ Basement w/plumbing ☐ Basement wo/plumbing

Water Supply: ☐ Individual ☑ Public ☐ Community


Comments:/Conditions:

Comments:/Conditions: SEPTIC TANK WITH RISERS INSTALLED USING "POLY LOK" FILTER

INITIAL SITE SKETCH

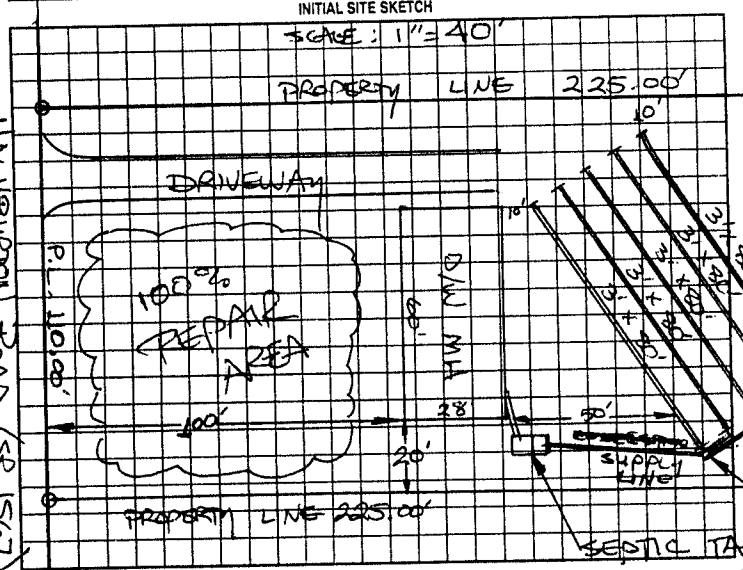

AS BUILT SKETCH

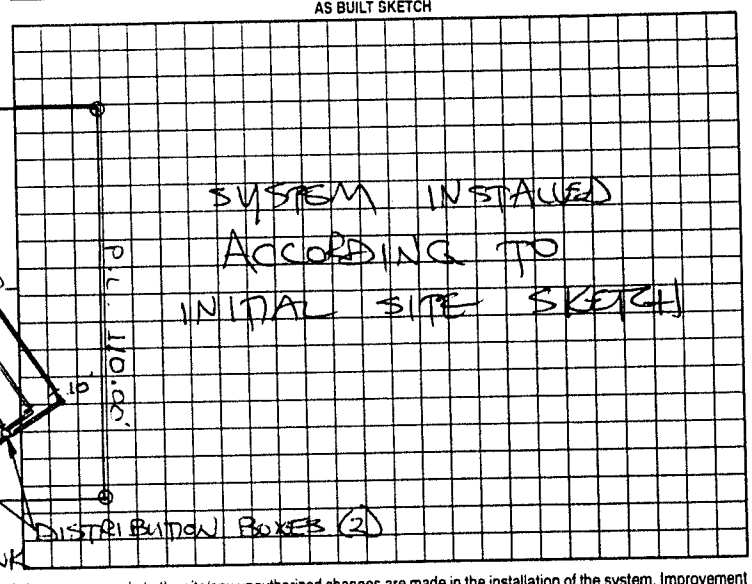

Permit can be suspended or revoked if any false information is supplied toward securing the permit/any unauthorized changes are made to the site/any unauthorized changes are made in the installation of the system. Improvement Permit with plat valid without expiration. Improvement Permit with site plan valid for sixty months. Authorization to Construct is valid for a period equal to that of Improvement Permit – not to exceed sixty months.

Signed: Stephen W Orrell date 1-31-00

Improvement Permit by: STEVE HEDRICK date 1-31-00

Authorization to Construct by: STEVE HEDRICK date 1-31-00

Installed by: CRAIG THOMPSON

Operation Permit by: STEVE HEDRICK date 3-1-00

Existing System Inspection by: date

HEALTH DEPT COPY: WHITE OWNER COPY (FINAL) YELLOW OWNER COPY (INITIAL): PINK