IREDELL COUNTY HEALTH DEPARTMENT

Statesville Office (704) 878-5305 Mooresville Office (704) 660-3625 PERMIT # 20196

IMPROVEMENT PERMIT / AUTHORIZATION TO CONSTRUCT / OPERATION PERMIT / EXISTING SYSTEM

PIN # 3797916037

APPLICANT: Mark Carter APPLICANT ADDRESS: 4941 Taylorsville Hwy Stony Point NC 28678

SITE ADDRESS: 118 Eller Dr Stoney Point NC 28678 PHONE: 704-880-8179 ALT. PHONE: N/A


SITE DIRECTIONS: Taylorsville Hwy T/L Eller drive directly behind 4941 Taylorsville Hwy

SUBDIVISION: N/A SECTION: N/A LOT # TR 1 LOT AREA: 6.05 ac DESIGN FLOW: 360 L.T.A.R.: .25

Septic Tank 1000 (gal)	STB 1000-DZL	Date 5-30-14	[X] New System [ ] Repair [ ] Expansion	System Type: I II (III) IV V VI	[X] Residence	No. Bedrooms 3	Water Supply
Pump Tank (gal)	PT	Date	System Description: 25% Reduction		[ ] Business	No. Persons 6	[ ] Private
Pump Make	Model	Serial #	Repair System Description: 25% Reduction		[ ] Other	No. Employees	[X] Public
# Nitrification Fields 1	# Lines 2	Linear Ft: 360	Maintenance Agreement Required:	[ ] YES [X] NO	[ ] Slab	[X] Crawl Space	[ ] Community
Trench Width 36"	Max. Trench Bottom Depth 36"	Gravel Depth N/A	[X] GRAVITY	[ ] PRESSURE	[ ] Basement w/plumbing		[ ] Basement w/o plumbing


Comments / Conditions: Install 25% reduction on contour with serial distribution.

INITIAL SITE SKETCH

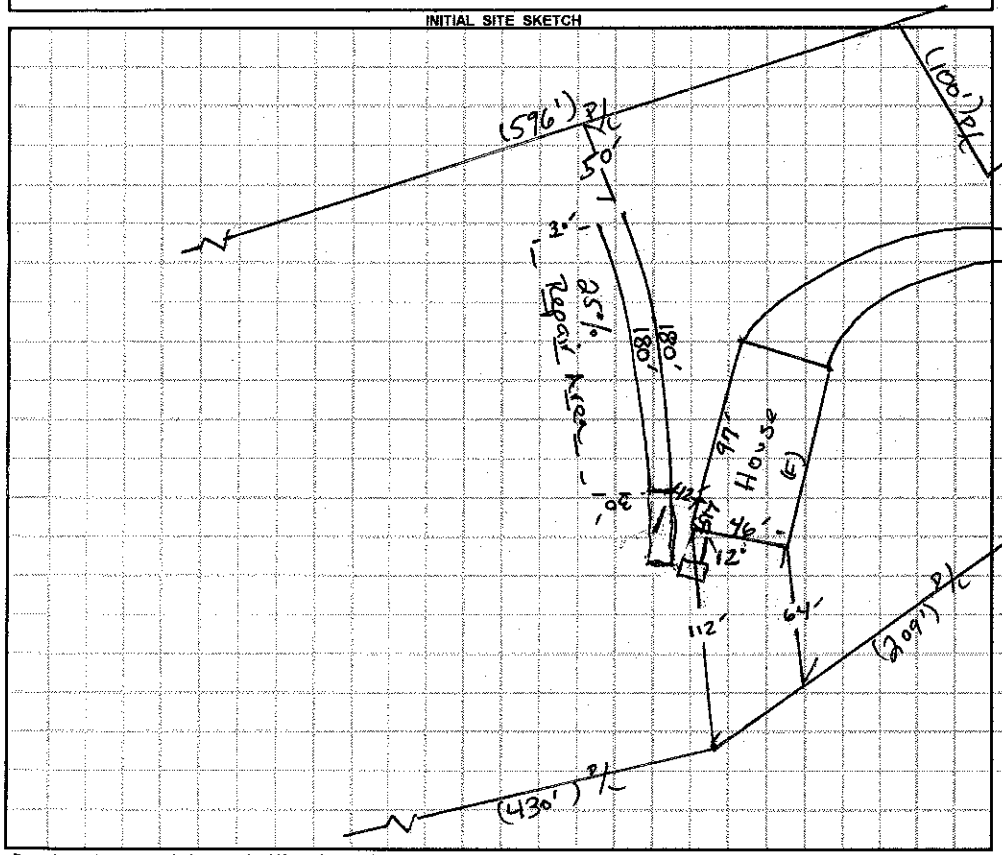

AS BUILT SKETCH

- Red Polylok filter installed
- Quick 4 Chambers installed
- Installed as drawn

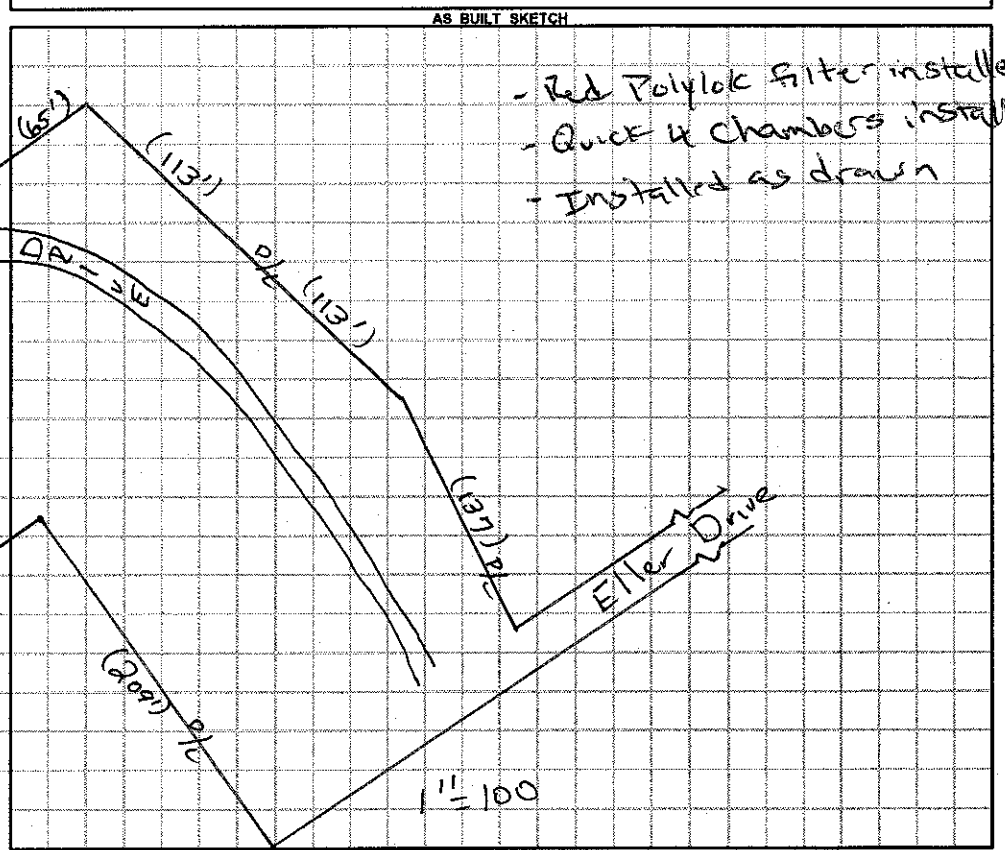

Permit can be suspended or revoked if any false information is supplied toward securing the permit / any unauthorized changes are made to the site / any unauthorized changes are made in the installation of the system. **CONTACT A LOCATOR SERVICE PRIOR TO ANY EXCAVATION**

[ ] **IMPROVEMENT PERMIT** *with plat valid without expiration.* [X] **IMPROVEMENT PERMIT** *with site plan valid for 60 mos.* [X] **AUTHORIZATION TO CONSTRUCT** *valid for period equal to IMPROVEMENT PERMIT--not to exceed 60 mo.*

Owner / Applicant Signature: Mark E. Carter Date: Installed by: Tim Summey

IMPROVEMENT PERMIT by: Date: 03/24/14 OPERATION PERMIT by: Date: 7-7-14

AUTHORIZATION TO CONSTRUCT by: Date: 03/24/14 Existing System Inspected by: Date:

Health Dept. Copy - WHITE Applicant (Final Approval) - YELLOW Applicant (Conditional Approval) - PINK