# IREDELL COUNTY HEALTH DEPARTMENT

STATESVILLE 704-878-5305 (C1) MOORESVILLE 704-664-5281

(C1) **IMPROVEMENT PERMIT / AUTHORIZATION TO CONSTRUCT / OPERATION PERMIT / EXISTING SYSTEM INSPECTION**

PERMIT# 145208 PIN# 3797-94-4269 92 DATE 9-12-2007

OWNER OR APPLICANT ROGER DALE STIKELEATHER PHONE: Business _____ Home 704-585-2658

ADDRESS 1713 MIDWAY ROAD, STONY POINT, NC 28678

LOCATION NC 90 WEST, TR/ MIDWAY ROAD, ON RIGHT AT BOX # 1713 JUST BEFORE OLIVER ROAD

SUBDIVISION _____ BLOCK / SECTION _____ LOT 1 LOT AREA 7.26 ACRES SITE CLASS. PS DESIGN FLOW 480 L.T.A.R. 0.25 GPD/FT²

Septic Tank: 1000 Gallons; STB 160 Date 8-9-07

Pump Tank: _____ Gallons; P.T _____ Date _____

Pump Make: _____ Model _____ Serial No. _____

Nitrification Field: No Fields 1 Square Feet 1920 Linear Feet 480

No Lines FOUR Trench Width 36" Max Trench Bottom Depth 36"

☑ New System ☐ Repair ☐ Expansion System Type: I II III IV V VI

System Description: 25% REDUCTION, GRAVITY

Repair System Description: 25% REDUCTION, GRAVITY

Maintenance Agreement Required: ☐ Yes ☑ No

Gravel Depth N/A ☑ Gravity ☐ Pressure ☐ Slab ☑ Crawl Space ☐ Basement w/plumbing ☐ Basement wo/plumbing

☐ House/Mod. Home No. Bedrooms 4

☑ Mobile Home No. Persons ____

☐ Business No. Employees ____


☐ Other _____

Water Supply: ☐ Individual ☑ Public ☐ Community


Comments:/Conditions: INSTALL 25% REDUCTION SYSTEM ON CONTOUR AS SHOWN

Comments:/Conditions: SEPTIC TANK W/ MARKER INSTALLED USING RED "POLY LOK" FILTER

INITIAL SITE SKETCH

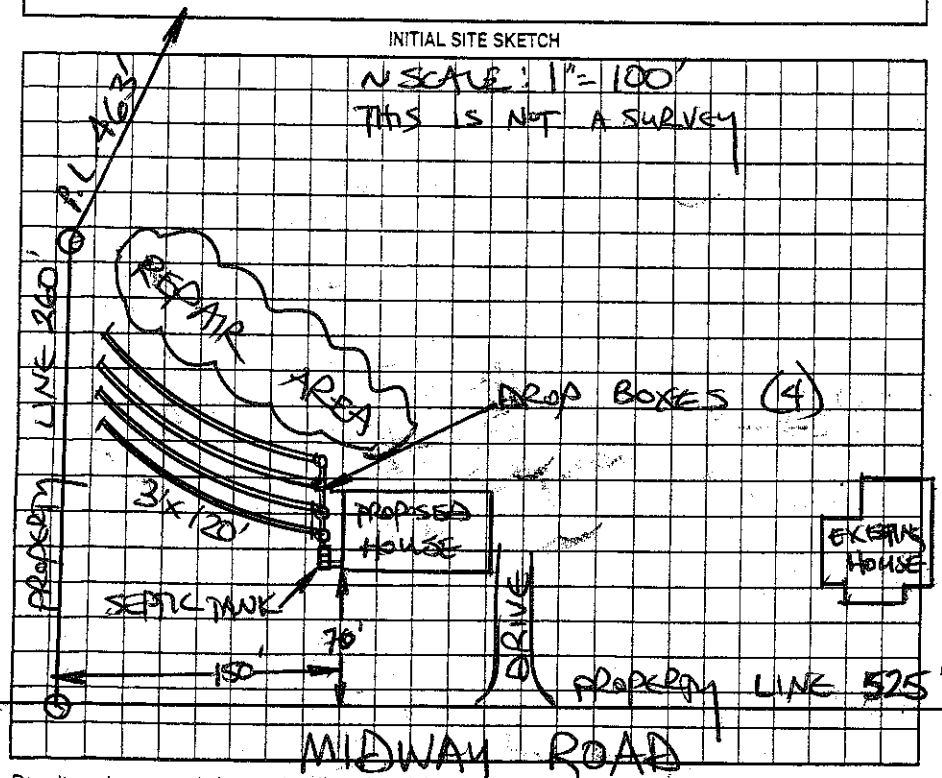


AS BUILT SKETCH

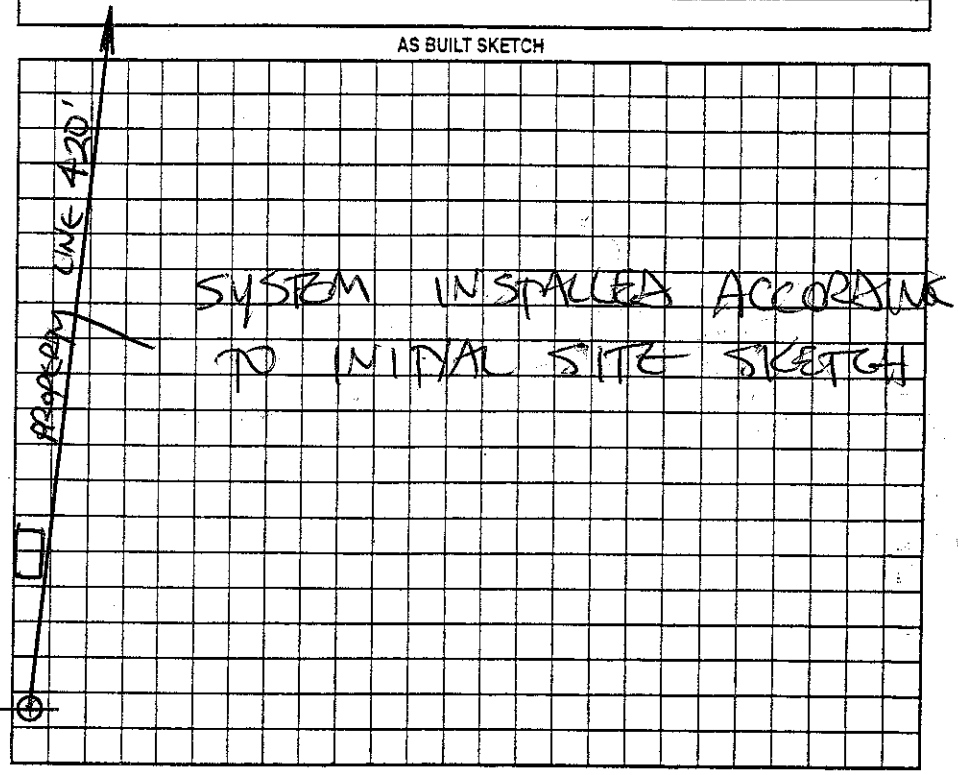


Permit can be suspended or revoked if any false information is supplied toward securing the permit/any unauthorized changes are made to the site/any unauthorized changes are made in the installation of the system. Improvement Permit with plat valid without expiration ☐ Improvement Permit with site plan valid for sixty months ☑ Authorization to Construct is valid for a period equal to that of Improvement Permit – not to exceed sixty months.

Signed: Dale Stikeleather date 9-12-07 Installed by: J. C. CONSTRUCTION

Improvement Permit by: STEVE HEDRICK date 9-12-2007 Operation Permit by: STEVE HEDRICK date 10-11-07

Authorization to Construct by: STEVE HEDRICK date 9-12-2007 Existing System Inspection by: _____ date _____

HEALTH DEPT. COPY: WHITE OWNER COPY (FINAL): YELLOW OWNER COPY (INITIAL): PINK