IREDELL COUNTY HEALTH DEPARTMENT

STATESVILLE 704-878-5305 MOORESVILLE 704-664-5281

IMPROVEMENT PERMIT / AUTHORIZATION TO CONSTRUCT / OPERATION PERMIT / EXISTING SYSTEM INSPECTION

DATE 1-18-00

PERMIT# REPAIR PIN#

OWNER OR CONTRACTOR RICHARD CASHION PHONE: Business Home 585-6536

ADDRESS 174 STIKELEATHER ROAD, STONY POINT, NC 28678

LOCATION NC 90 WEST, TR MIDWAY ROAD, TL STIKELEATHER ROAD, 0.3 MILES ON RIGHT AT BOX # 174

SUBDIVISION BLOCK / SECTION LOT LOT AREA ACREAGE SITE CLASS. PS DESIGN FLOW 360 L.T.A.R.

Septic Tank: EXISTING Gallons: STB Date

Pump Tank: Gallons: PT Date

Pump Make: Model Serial No.

Nitrification Field: No Fields 1 Square Feet 300 Linear Feet 100

No Lines 1 Trench Width 36" Max Trench Bottom Depth 36" Gravel Depth 18"

☐ New System ☑ Repair System Type: I (II) III. IV. V. VI

System Description: CONVENTIONAL GRAVITY

Repair System Description: CONVENTIONAL GRAVITY

Maintenance Agreement Required: ☐ Yes ☑ No

☑ House/Mod. Home ☐ Mobile Home ☐ Business ☐ Other

No. Bedrooms 3 No. Bathrooms 2½ No. Employees


☐ Slab ☐ Crawl Space ☐ Basement w/plumbing ☐ Basement wo/plumbing

Water Supply: ☑ Individual ☐ Public ☐ Community WELL


Comments:/Conditions: ① REPLACE SANITARY TEE IN SEPTIC TANK IF NECESSARY ② INSTALL NEW DISTRIBUTION BOX AT LOCATION SHOWN IF NECESSARY, FEEDING OLD DRAW LINES FIRST. ③ USE 18" STONE

Comments:/Conditions:

INITIAL SITE SKETCH

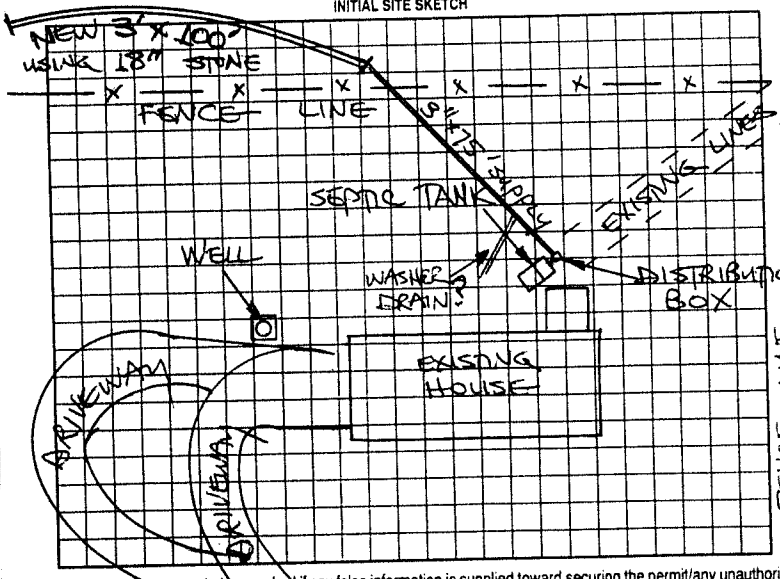

AS BUILT SKETCH

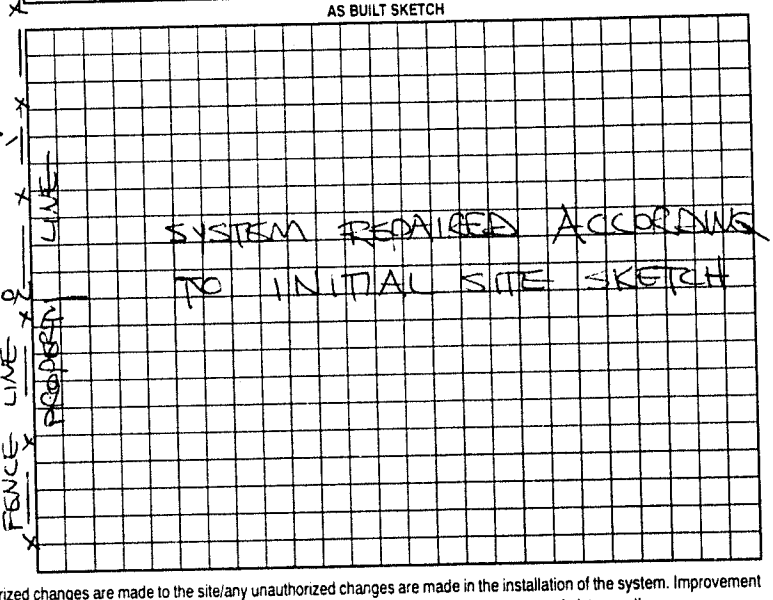

Permit can be suspended or revoked if any false information is supplied toward securing the permit/any unauthorized changes are made to the site/any unauthorized changes are made in the installation of the system. Improvement Permit with plat valid without expiration. Improvement Permit with site plan valid for sixty months. Authorization to Construct is valid for a period equal to that of Improvement Permit – not to exceed sixty months.

Signed: [signature] date 1-13-00 Installed by: EAGLE GRADING

Improvement Permit by: STEVE HEDRICK date 1-13-00 Operation Permit by: STEVE HEDRICK date 2-24-00

Authorization to Construct by: STEVE HEDRICK date 1-13-00 Existing System Inspection by: date

HEALTH DEPT. COPY: WHITE OWNER COPY (FINAL): YELLOW OWNER COPY (INITIAL): PINK