IREDELL COUNTY HEALTH DEPARTMENT

STATESVILLE 704-878-5305 MOORESVILLE 704-664-5281

IMPROVEMENT PERMIT / AUTHORIZATION TO CONSTRUCT / OPERATION PERMIT / EXISTING SYSTEM INSPECTION

PERMIT# 071586 PIN# 3798 97 9139 DATE 1-29-98

OWNER OR CONTRACTOR ROBERT D. SNIDER PHONE: Business Home 663-0336

ADDRESS 125 BARKLAND DRIVE, MOORESVILLE, NC 28115

LOCATION NC 90 W, TR CHEATHAM FORD, TR HUCKLEBERRY RIDGE, TR LAMBERT ROAD, 1.0 MILE ON LEFT AT

SUBDIVISION BLOCK / SECTION LOT LOT AREA 9.49 ACRES SITE CLASS. PS DESIGN FLOW 360 L.T.A.R. 0.35 GPD/FT²

Septic Tank: 1000 Gallons; STB 786 Date 1-25-98

Pump Tank: Gallons; PT Date

Pump Make: Model Serial No.

Nitrification Field: No Fields 1 Square Feet 1035 Linear Feet 345

No Lines THREE Trench Width 36" Max Trench Bottom Depth 36" Gravel Depth 12"

☑ New System ☐ Repair System Type: I ☐ II, III, IV, V, VI

System Description: CONVENTIONAL GRAVITY

Repair System Description: CONV. GRAVITY

Maintenance Agreement Required: ☐ Yes ☑ No

☐ House/Mod. Home ☑ Mobile Home ☐ Business ☐ Other FUTURE 3BR

No. Bedrooms 2 No. Bathrooms 1½ No. Employees


☐ Slab ☑ Crawl Space ☐ Basement w/plumbing ☐ Basement wo/plumbing

Water Supply: ☑ Individual ☐ Public ☐ Community WELL

Comments:/Conditions: KEEP SYSTEM MINIMUM 100' FROM WELL SITE

Comments:/Conditions:

INITIAL SITE SKETCH SCALE: 1"=60'

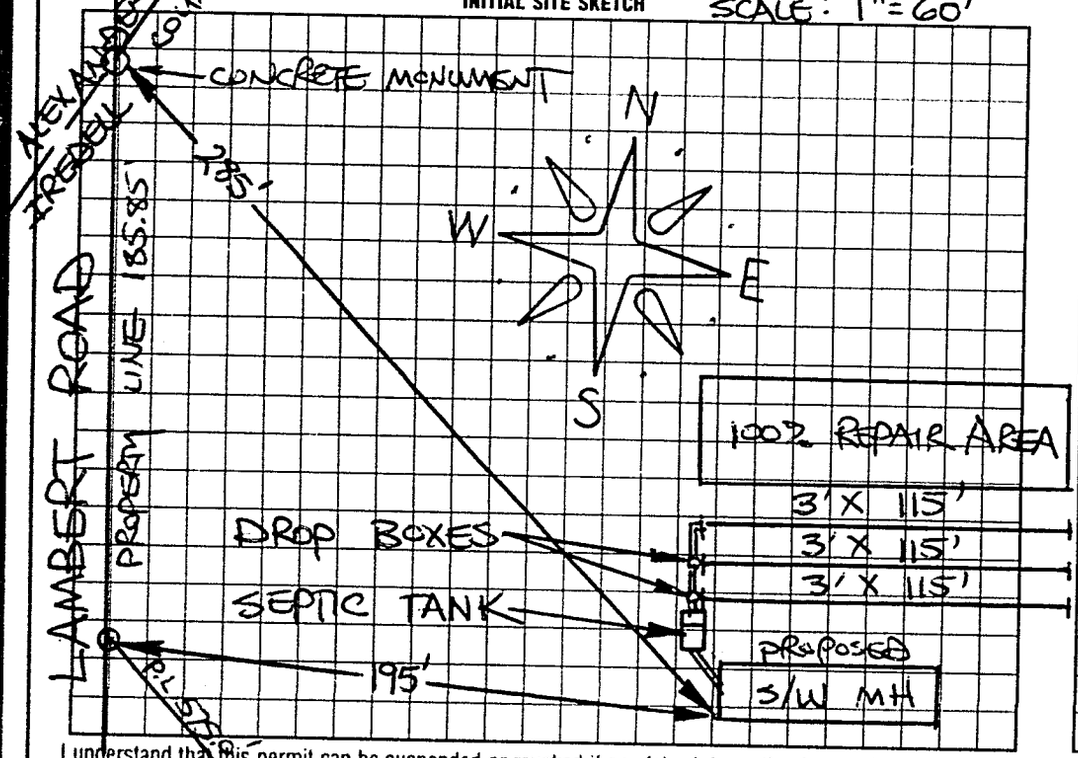

AS BUILT SKETCH

Installed as shown

I understand that this permit can be suspended or revoked if any false information is supplied toward securing the permit/any unauthorized changes are made to the site/any unauthorized changes are made in the installation of the system. Improvement Permit with plat valid without expiration. Improvement Permit with site plan valid for sixty months. Authorization to Construct is valid for a period equal to that of Improvement Permit – not to exceed sixty months.

Signed: [signature] date

Improvement Permit by: STEVE HENDRICK date 1-29-98

Authorization to Construct by: STEVE HENDRICK date 1-29-98

Installed by: Charlie Brice

Operation Permit by: Mary Coutts date 3-26-98

Existing System Inspection by date

HEALTH DEPT COPY WHITE INSPECTION COPY (FINAL) GREEN OWNER COPY (FINAL) YELLOW INSPECTION COPY (INITIAL) PINK OWNER COPY (INITIAL) GOLD

8/2000