IREDELL COUNTY HEALTH DEPARTMENT

STATESVILLE 704-878-5305 MOORESVILLE 704-664-5281

IMPROVEMENT PERMIT / AUTHORIZATION TO CONSTRUCT / OPERATION PERMIT / EXISTING SYSTEM INSPECTION

PERMIT# 107480 PIN# 3798-97-9939 DATE 7/9/02

OWNER OR CONTRACTOR Robert + Teresa Snider PHONE Business — Home (828) 635-0940

ADDRESS 975 Lambert Road Hiddenite, N.C. 28636

LOCATION Hwy 90 W to Cheatam Ford Road to Huckleberry Ridge Road to Lambert Road, 1.0 mile on Left.

SUBDIVISION — BLOCK / SECTION — LOT L LOT AREA 9.49 Ac SITE CLASS PS DESIGN FLOW 360 L.T.A.R. 330 gpd

Septic Tank: 1,000 Gallons; STB ____ Date ____

Pump Tank: ____ Gallons; PT ____ Date ____

Pump Make: ____ Model ____ Serial No ____

Nitrification Field: No Fields 1 Square Feet 1029 Linear Feet 345

No Lines 3 Trench Width 36" Max Trench Bottom Depth 36" Gravel Depth 12"

☐ New System ☐ Repair System Type: I II III IV V VI

System Description: Conventional Gravity

Repair System Description: Conventional Gravity

Maintenance Agreement Required: ☐ Yes ☐ No

☐ Slab ☒ Crawl Space ☐ Basement w/plumbing ☐ Basement wo/plumbing

☒ House/Mod. Home No. Bedrooms 3

☐ Mobile Home No. Bathrooms 2

☐ Business No. Employees ____

☐ Other ____


Water Supply: ☒ Individual ☐ Public ☐ Community

Comments/Conditions:

Comments/Conditions Existing System Okay at time of Inspection. Keep New Home Sfr from S.T. and Septic Lines.

INITIAL SITE SKETCH

AS BUILT SKETCH

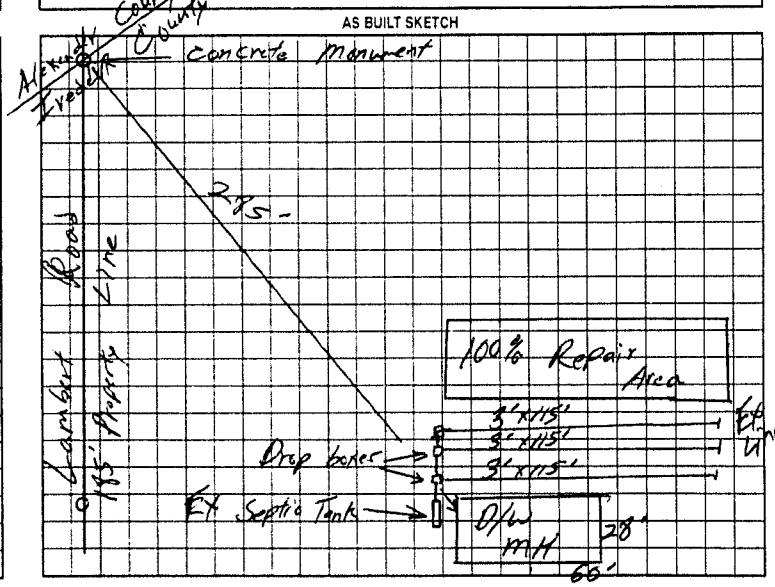

Permit can be suspended or revoked if any false information is supplied toward securing the permit/any unauthorized changes are made to the site/any unauthorized changes are made in the installation of the system. Improvement Permit with plat valid without expiration. Improvement Permit with site plan valid for sixty months. Authorization to Construct is valid for a period equal to that of Improvement Permit – not to exceed sixty months

Signed: [signature] date 7-9-02 Installed by: ____

Improvement Permit by: ____ date ____ Operation Permit by: ____ date ____

Authorization to Construct by: ____ date ____ Existing System Inspection by: William C. Johnson date 7/9/02

HEALTH DEPT COPY: WHITE OWNER COPY (FINAL): YELLOW OWNER COPY (INITIAL): PINK