IREDELL COUNTY HEALTH DEPARTMENT

STATESVILLE 704-878-5305 MOORESVILLE 704-664-5281

IMPROVEMENT PERMIT / AUTHORIZATION TO CONSTRUCT / OPERATION PERMIT / EXISTING SYSTEM INSPECTION

PERMIT # 156794 PIN # 4614647513 DATE 6/4/09

OWNER or APPLICANT Carolina Bldg. Group PHONE: Business 704.532.4633 Home:

OWNER or APPLICANT ADDRESS 5810 Monroe Rd. Charlotte, NC 28212

LOCATION / DIRECTIONS Brawley School Rd, TR Tuskaroora, TR Sunstate, TR Strawpacket, on Lft

SUBDIVISION Clift BLOCK / SECTION 10 LOT # 289 LOT AREA 0.65ac DESIGN FLOW 240 gal/d L.T.A.R. —

Septic Tank exist 1000 Gallons: STB exist Date exist

Pump Tank — Gallons: P T Date —

Pump Make — Model — Serial # —

Nitrification Field No Fields 1 No Lines bed Linear Feet 7X67

Trench Width — Max. Trench Bottom Depth — Gravel Depth —

☐ New System ☐ Repair ☐ Expansion System Type I II III IV V VI

System Description: existing gravel bed gravity

Repair System Description: exempt

Maintenance Agreement Required ☐ YES ☒ NO

☒ GRAVITY ☐ PRESSURE

☒ Residence No. Bedrooms 2

☐ Business No. Persons —

☐ Other No. Employees —

☐ Slab ☐ Crawl Space

☐ Basement w/plumbing ☒ Basement w/o plumbing


Water Supply: ☒ Private ☐ Public ☐ Community

Comments / Conditions


* Existing permit only
* New addition work to not affect existing system

Comments / Conditions

INITIAL SITE SKETCH

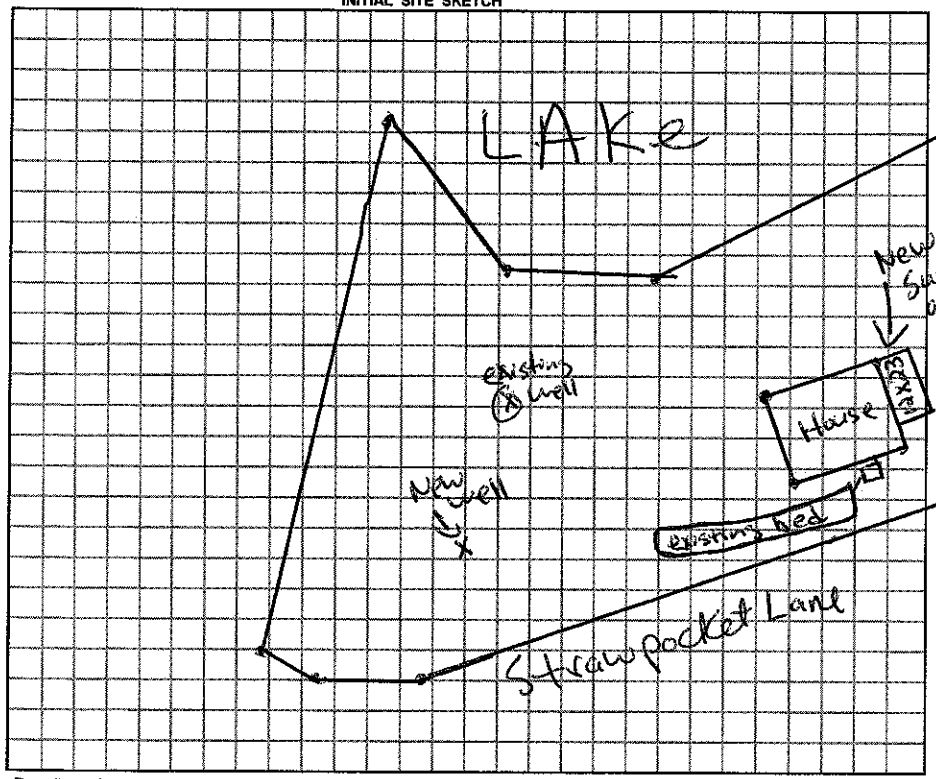

AS BUILT SKETCH

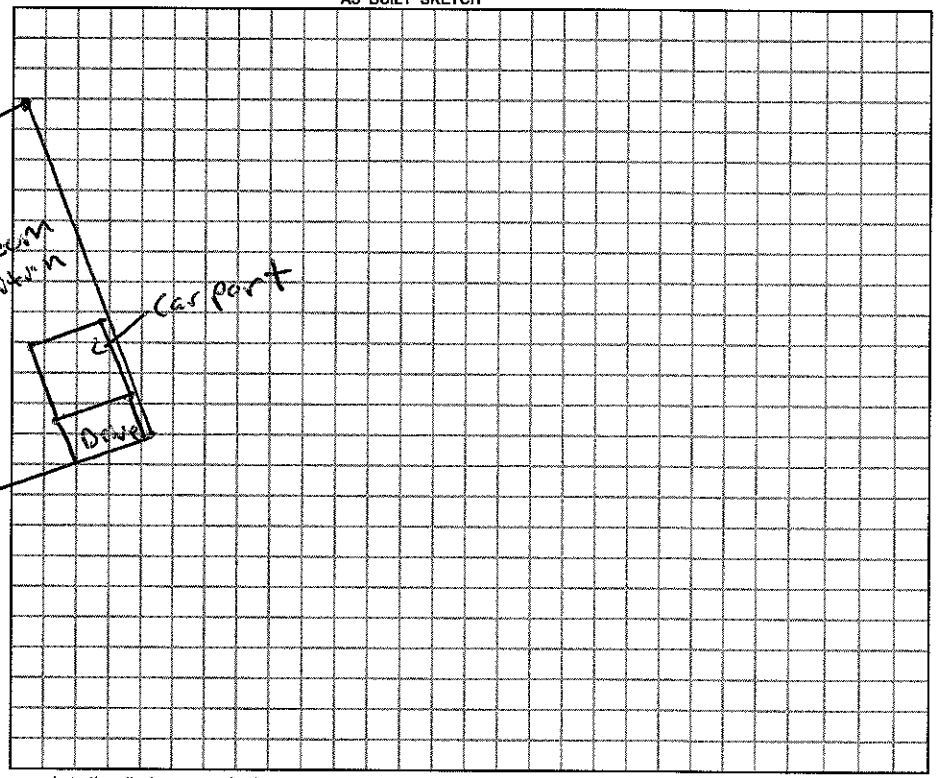

Permit can be suspended or revoked if any false information is supplied toward securing the permit / any unauthorized changes are made to the site / any unauthorized changes are made in the installation of the system.

☐ *IMPROVEMENT PERMIT w / plat valid without expiration.* ☐ *IMPROVEMENT PERMIT w / site plan valid for 60 mos.* ☐ *AUTHORIZATION TO CONSTRUCT valid for period equal to IMPROVEMENT PERMIT-not to exceed 60 mo.*

Owner / Applicant Signature: [signature] Date 6/10/09

Improvement Permit by: — Date —

Authorzation to Construct by: — Date —

YOU SHOULD CONTACT A LOCATOR SERVICE PRIOR TO ANY EXCAVATION.

Installed by: —

Operation Permit by: — Date —

Existing System Inspected by: [signature] Date 6/4/09

WHITE COPY Environmental Health YELLOW COPY (Final) Owner / Applicant PINK COPY (Initial) Owner / Applicant