IREDELL COUNTY HEALTH DEPARTMENT

STATESVILLE 704-878-5305 MOORESVILLE 704-664-5281

IMPROVEMENT PERMIT / AUTHORIZATION TO CONSTRUCT / OPERATION PERMIT / EXISTING SYSTEM INSPECTION

PERMIT # 133812 PIN # 4614 72 3966 DATE 8/17/2010

OWNER or APPLICANT KUMBLA S. RAO PHONE: Business 423-596-1122 Home:

OWNER or APPLICANT ADDRESS 321 W McNeely Ave

LOCATION / DIRECTIONS 106 BIRDSONG LN. / 1100 TR TUSKARORA TR. TO END (R) ON BIRDSONG HOUSE ON R. DRAINFIELD ON L

SUBDIVISION CL+T / TUSKARORA PT. BLOCK / SECTION 6 / 24 LOT # 308 / LOT AREA .69AC DESIGN FLOW 480 L.T.A.R. .25

Septic Tank 1000 Gallons: STB 760 Date 6/09

Pump Tank 1000 Gallons: PT 363 Date 9/09

Pump Make GOULDS Model WE0-511 N Serial # 11/09

Nitrification Field No Fields 1 No Lines 4 Linear Feet 320

Trench Width 3 Max. Trench Bottom Depth 3' Gravel Depth N/A

[X] New System [ ] Repair [ ] Expansion System Type I II III (IV) V VI

System Description: PRES - 16" PPBPS

Repair System Description: SAME TYPE

Maintenance Agreement Required [X] YES [ ] NO

[ ] GRAVITY [X] PRESSURE

[X] Residence No. Bedrooms 4

[ ] Business No. Persons

[ ] Other No. Employees

[ ] Slab [ ] Crawl Space


[X] Basement w/plumbing [ ] Basement w/o plumbing

Water Supply: [X] Private [ ] Public [ ] Community


Comments / Conditions

Comments / Conditions

INITIAL SITE SKETCH

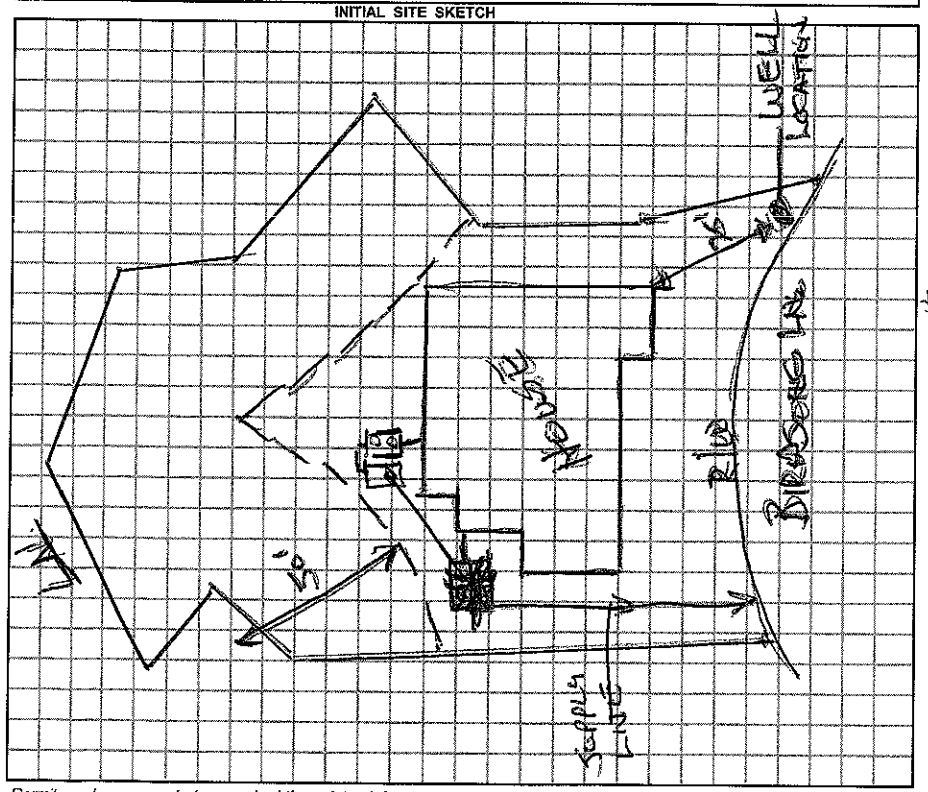

AS BUILT SKETCH

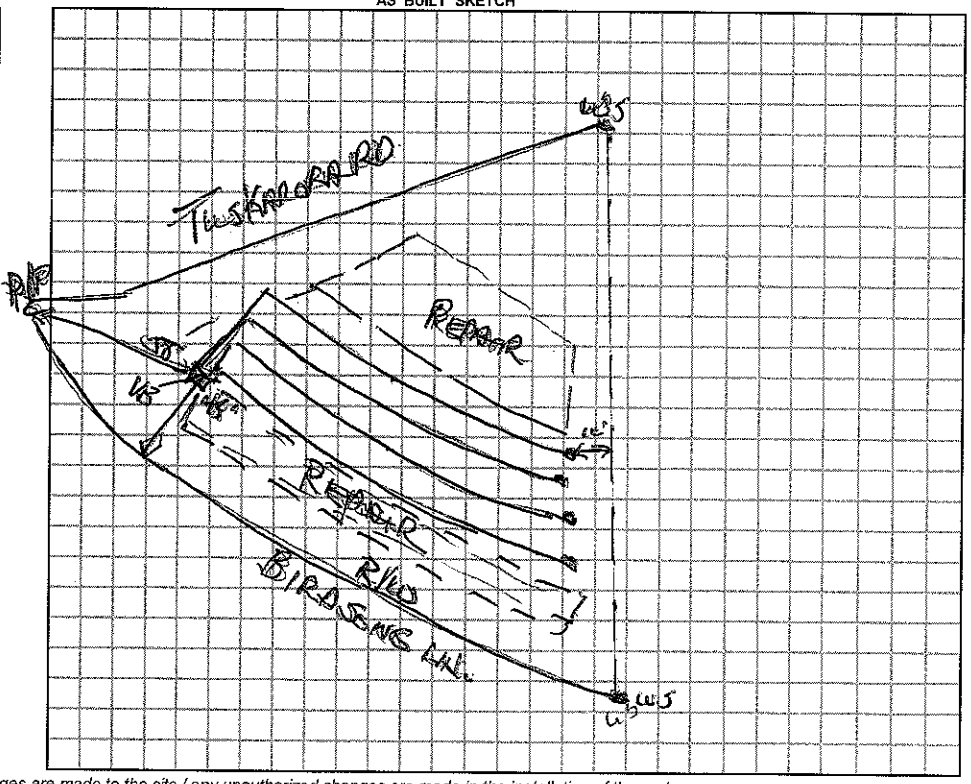

Permit can be suspended or revoked if any false information is supplied toward securing the permit / any unauthorized changes are made to the site / any unauthorized changes are made in the installation of the system.

[ ] *IMPROVEMENT PERMIT w / plat valid without expiration.* [ ] *IMPROVEMENT PERMIT w / site plan valid for 60 mos.* [ ] *AUTHORIZATION TO CONSTRUCT valid for period equal to IMPROVEMENT PERMIT-not to exceed 60 mo.*

Owner / Applicant Signature: AWS Date 4/20/09

Improvement Permit by: AWS Date 4/20/09

Authorzation to Construct by: AWS Date 4/20/09

Installed by: Al Barkhau

Operation Permit by: Wesley Sparks RS. Date: 8/19/2010

Existing System Inspected by: Date:

YOU SHOULD CONTACT A LOCATOR SERVICE PRIOR TO ANY EXCAVATION.

WHITE COPY Environmental Health YELLOW COPY (Final) Owner / Applicant PINK COPY (Initial) Owner / Applicant