IREDELL COUNTY HEALTH DEPARTMENT

STATESVILLE 704-878-5305 MOORESVILLE 704-664-5281

IMPROVEMENT PERMIT / AUTHORIZATION TO CONSTRUCT / OPERATION PERMIT / EXISTING SYSTEM INSPECTION

PERMIT# Repair PIN# 4614741152 DATE 5/3/04

OWNER OR CONTRACTOR George + Linda Irons PHONE: Business Home (704) 660-5766

ADDRESS 211 Sunstede Dr. Mooresville NC 28117

LOCATION BSR, TR Tuscarora, TR Sunstede, on Lt #211

SUBDIVISION Meck-Neck Class BLOCK/SECTION 6 LOT 294 LOT AREA .73 Ac SITE CLASS PS DESIGN FLOW 360 L.T.A.R. —

Septic Tank: ~~Exist~~/Existing Gallons: STB ____ Date ____

Pump Tank: 1000 Gallons: PT 283 Date 4/6/04

Pump Make: Goulds Model WE05511 Serial No. ____

Nitrification Field: No Fields 1 Square Feet 771 Linear Feet 257

No Lines 3 @ 86' Trench Width 36" Max Trench Bottom Depth 36" Gravel Depth —

☐ New System ☒ Repair System Type: I, II, (III), IV, V, VI

System Description: ____

Repair System Description: PM 25% Reduction

Maintenance Agreement Required: ☐ Yes ☒ No

☒ House/Mod. Home ☐ Mobile Home ☐ Business ☐ Other

No. Bedrooms 5 No. Bathrooms 2½ No. Employees ____


☐ Slab ☐ Crawl Space ☒ Basement w/plumbing ☐ Basement wo/plumbing

Water Supply: ☒ Individual ☐ Public ☐ Community

Comments:/Conditions: Sleeve Supply Line Inside 50' of well
Can use Existing Septic tank

Comments:/Conditions:

INITIAL SITE SKETCH

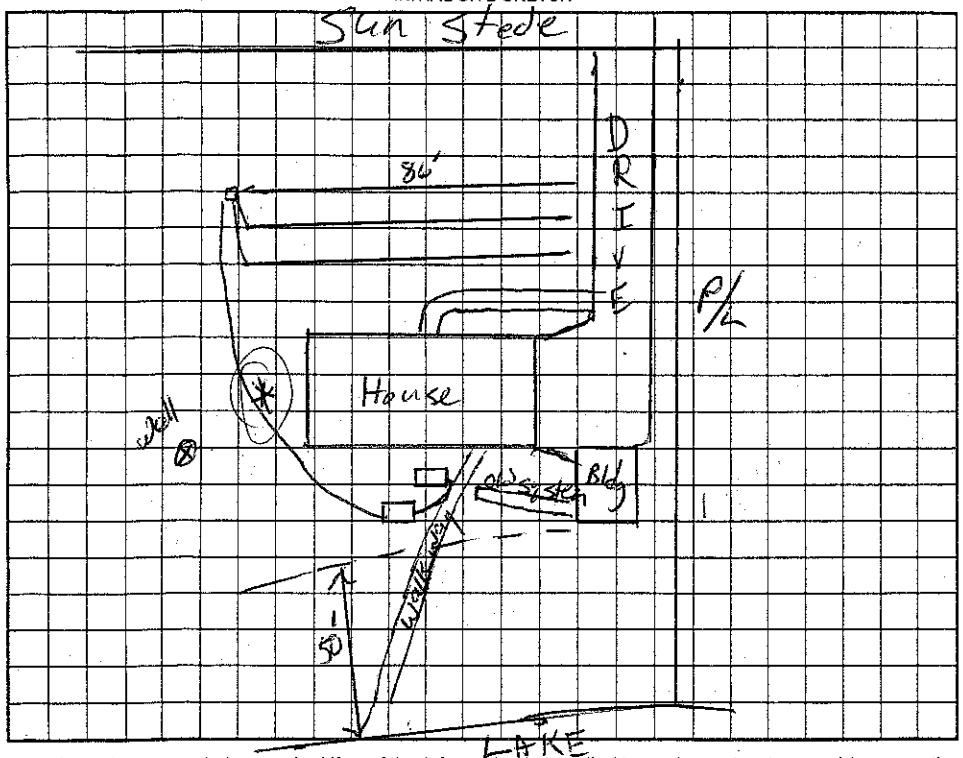

AS BUILT SKETCH

Permit can be suspended or revoked if any false information is supplied toward securing the permit/any unauthorized changes are made to the site/any unauthorized changes are made in the installation of the system. Improvement Permit with plat valid without expiration. Improvement Permit with site plan valid for sixty months. Authorization to Construct is valid for a period equal to that of Improvement Permit – not to exceed sixty months.

Signed: Linda G. Irons date ____

Improvement Permit by: RS date 5/3/04

Authorization to Construct by: RS date 5/3/04

Installed by: Atkinson

Operation Permit by: RS date 5/12/04

Existing System Inspection by: ____ date ____

HEALTH DEPT. COPY: WHITE OWNER COPY (FINAL): YELLOW OWNER COPY (INITIAL): PINK