2100

IREDELL COUNTY HEALTH DEPARTMENT - *ENVIRONMENTAL HEALTH* ☐ STATESVILLE OFFICE 704-878-5305 ☒ MOORESVILLE OFFICE 704-664-5281

IMPROVEMENT PERMIT / AUTHORIZATION TO CONSTRUCT / OPERATION PERMIT / EXISTING SYSTEM INSPECTION

PERMIT # 17072 PIN # 4614744342 DATE 4-30-2012

OWNER Mike Shalvoy APPLICANT: Mike Shalvoy PHONE: Home/Cell # 7046626991 Business # 980 722 1118

SITE ADDRESS 201 Sunstede, M'ville OWNER / APPLICANT ADDRESS 289 Chandelew Dr

SITE DIRECTIONS Brawley School Rd TR Tuskarora TR Sunstede on left #201

SUBDIVISION CL & T BLOCK / SECTION C LOT # 296 LOT AREA .99 Ac. DESIGN FLOW 480 L.T.A.R. .3

Septic Tank 1000 Gallons: STB 338 Date 11-12-11 ☒ New System ☐ Repair ☐ Expansion System Type I II III IV V VI

Pump Tank Gallons: PT Date System Description: Gravity - 25% Reduction

Pump Make Model Serial # Repair System Description: Pump - 25-50% Reduction

No. Nitrification Fields: 1 No. Lines 5 Linear Feet 400' Maintenance Agreement Required ☐ YES ☒ NO

Trench Width 36" Max. Trench Bottom Depth 24"-36" Gravel Depth N/A ☒ GRAVITY ☐ PRESSURE


☒ Residence ☐ Business ☐ Other ☒ Slab — No. Bedrooms 4 — No. Persons — No. Employees — ☐ Crawl Space ☐ Basement w/plumbing ☐ Basement w/o plumbing

Water Supply: ☐ Private ☐ Public ☐ Community

Comments / Conditions: Try to keep 24" trench bottom on Upper Trenches OK to be 36" on lower Trenches. Keep Septic System 50ft from any well, 50ft from lake & 5ft from house

* Serial distribution on drainlines. (Use "multi-port") to center feed long lines. Keep Supply line at least 25ft to lake. Okay to end feed lines if preferred Note: Any Future Pool must be 15ft from Septic

INITIAL SITE SKETCH

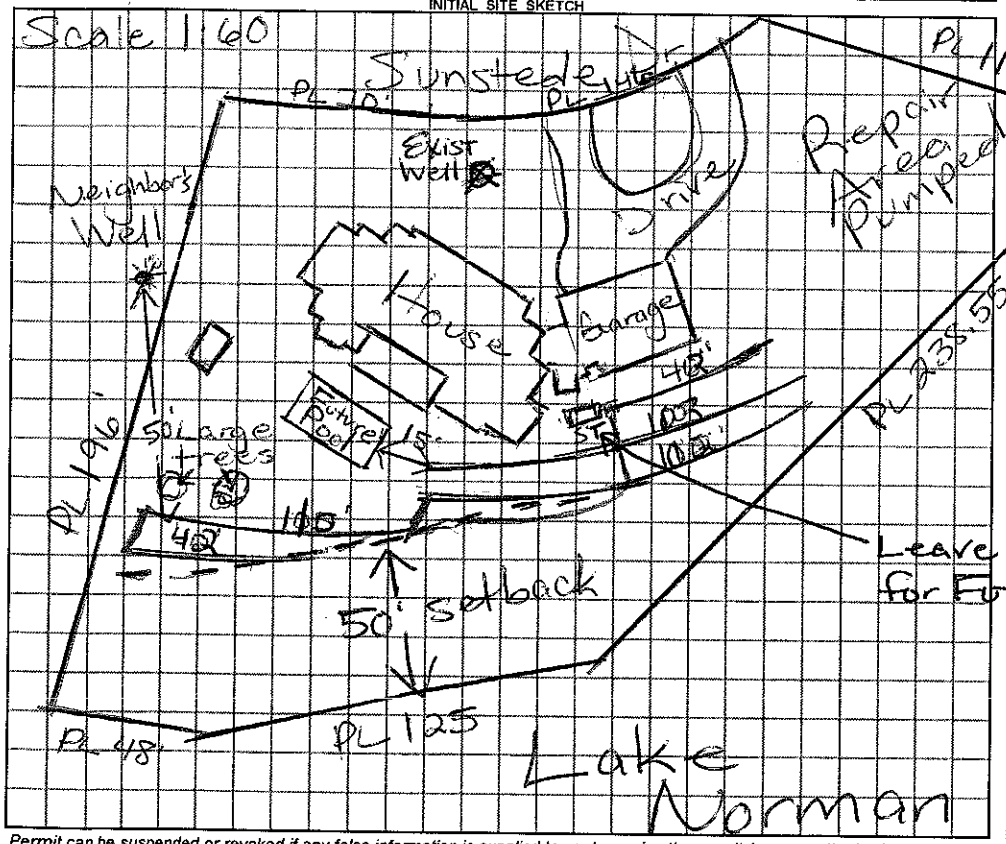

AS BUILT SKETCH

Used Quick 4. Installed as Drawn

Permit can be suspended or revoked if any false information is supplied toward securing the permit / any unauthorized changes are made to the site / any unauthorized changes are made in the installation of the system.

☐ ***IMPROVEMENT PERMIT*** *with plat valid without expiration.* ☐ ***IMPROVEMENT PERMIT*** *with plat valid without expiration. Site plan valid 60 mo.* ☐ ***AUTHORIZATION TO CONSTRUCT*** valid for period equal to IMPROVEMENT PERMIT--not to exceed 60 mo.

Owner / Applicant Signature: Mike Shalvoy Date 5/2/12 Installed by: Larry Henkle

IMPROVEMENT PERMIT by: Maine Hill REHS Date 4/30/12 OPERATION PERMIT by: Maine Hill REHS Date 5/11/2012

AUTHORIZATION TO CONSTRUCT by: Maine Hill REHS Date 4/30/12 Existing System Inspected by: REHS Date

YOU SHOULD CONTACT A LOCATOR SERVICE PRIOR TO ANY EXCAVATION

White Copy -- Environmental Health YELLOW COPY (Final) Owner / Applicant PINK COPY (Initial) Owner / Applicant